

**LAND CORNER RECORDATION CERTIFICATE**  
 Filing Requirement of Act 74, Mich. P.A. 1970 as Amended

For corners in

Baraga	Located In:	Corner Code #
(County)		
1. Public Land Survey	T 50N R 34W	J7
	T R	(GCDB 540400)
	T R	
2. Property Controlling in Section	S 22 T 50N R 34W	16
	S T R	(GCDB 460300)
	S T R	
3. Miscellaneous Property in Sec.	S T R	
	S T R	
4. Lot No. _____, Recorded Plat		
5. Private Claims		

Register of Deeds Stamp & File Number

	A	B	C	D	E	F	G	H	I	J	K	L	M
1													
2	6	5	4	3	2	1							
3													
4	7	8	9	10	11	12							
5													
6	18	17	16	15	14	13							
7													
8	19	20	21	22	23	24							
9													
10	30	29	28	27	26	25							
11													
12	31	32	33	34	35	36							
13													

I, Stephan J. Szyszkoski, in a field survey on J7 11/02/15 do hereby state that under requirements of P.A. 74, Michigan P.A. of 1970, the corner points mentioned in lines 1 and 2 above were in conformance with regulations and rules therefore as required in the current manual of survey instructions of the United States Department of the Interior, Bureau of Land Management or by a decree of a Court of Law and /or that the corner points mentioned in lines 3, 4 and 5 above were in conformance with the rules of the Michigan Board of Land Surveyors or by a Decree of a Court of Law; established, re-established, monumented, recovered, found as expressed below:

**NOTE: Not more than 2 corners, all in the same town and range, may be recorded on this certificate.**

**A. Description of original monument and accessories and/or subsequent restoration:**

(16-Sec. 22) East 1/16 corner between Sections 22 and 27. Not previously monumented.

(J7) Quarter corner common to Sections 14 and 23. 1849 - Established by Wm. Burt, Deputy, midway and on the Section line between Section corners 40.33 chains east and west. Set Y.Birch post. Y.Birch 7" N47°W 43 links, Hemlock 12" S86°E 21 links. 1854 - Examination by A.B.Wood, Deputy: Hemlock 14" S89°E 21 links, Y.Birch 7" N47°W 5 links. 1976 - A.O.Enger RLS remonumented the corner by proportionate measurement, noting that the Section line is 1.98 ch. short of record.

**B. Description of corner evidence found and/or method applied in restoring or reestablishing corner:**

(16-Sec. 22) Established the position for the corner midway and on the Section line between Quarter corner 1313.61' west and Section corner 1313.61' east.

(J7) The original post and accessories were not recovered. Found the 1976 monument in good condition at record bearing and distance from the 1976 accessories. Determined that Mr. Enger's observation as to the shortage across this section was due to a blunder that he made in his 1976 field measurements and not a result of an error in the original survey. Consequently, I did not accept the 1976 position but I reestablished the position for the corner midway and on the Section line between I7 (also reestablished on this survey) and K7 (found iron pipe). Destroyed the 1976 monument.

**C. Description of monument for corner and accessories established to perpetuate locating the position of the corner:**


(16) Set 1"IDx28" I.pipe with 2" alum. MDNR cap. Set measuring nail with MDNR tag in the side of:  
 18" Y.Birch N19°W 34.1'                      mrkd "1/16S BT"  
 19" Sugar N58°E 47.5'                      do  
 11" Y.Birch S56°E 15.65'                      do  
 6" Sugar S48°W 34.5'                      do  
 Set sq'd cedar post adjacent.  
 E= 7882465.791 N= 215082.154

(J7) Set 1"IDx28" I.pipe with 2" alum. MDNR cap. Set measuring nail with MDNR tag in the side of:  
 17" Maple N19°E 17.9'                      mrkd "1/4S NBT"  
 4" Sugar S84°E 16.35'                      do  
 11" Y.Birch S25°W 5.7'                      do  
 8" Maple N33°W 22.2'                      do  
 Set sq'd cedar post adjacent.  
 E= 7883708.322 N= 216645.273

**Bearings are magnetic.** Coordinates are MCS83 in meters, NAD83(2011) Epoch 2010.00 datum  
 Coord. Ref.=NGS PID DO8499: N= 221257.621 m. E= 7884435.168 m.

Signed by Stephan J. Szyszkoski  
 Surveyor's Michigan License No. 33986

Date 01/21/2016

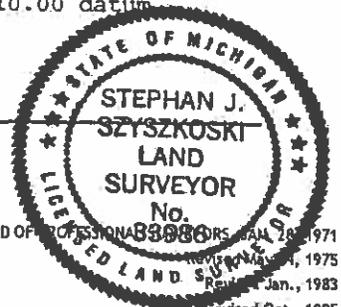

For the Michigan Department of Natural Resources, Forest Resources Division