

LAND CORNER RECORDATION CERTIFICATE
Filing Requirement of Act 74, Mich. P.A. 1970 as Amended

For corners in

Baraga (County)	Located In:	Corner Code #
1. Public Land Survey	T 51N R 32W	110
	T R	
	T R	
2. Property Controlling in Section	S T R	
	S 27 T 51N R 32W	6
	S T R	
3. Miscellaneous Property in Sec.	S T R	
	S T R	
4. Lot No. , Recorded Plat		
5. Private Claims		

Register of Deeds Stamp & File Number

	A	B	C	D	E	F	G	H	I	J	K	L	M
1													
2	6		5		4		3		2		1		
3													
4	7		8		9		10		11		12		
5													
6	18		17		16		15		14		13		
7													
8	19		20		21		22		23		24		
9													
10	30		29		28		27		26		25		
11													
12	31		32		33		34		35		36		
13													

I, Stephan J. Szyszkoski, in a field survey on 6 03/22/2011 do hereby state
that under requirements of P.A. 74, Michigan P.A. of 1970, the corner points mentioned in lines 1 and 2
above were in conformance with regulations and rules therefore as required in the current manual of survey
instructions of the United States Department of the Interior, Bureau of Land Management or by a decree of
a Court of Law and /or that the corner points mentioned in lines 3, 4 and 5 above were in conformance with
the rules of the Michigan Board of Land Surveyors or by a Decree of a Court of Law; established,
re-established, monumented, recovered, found as expressed below:

NOTE: Not more than 2 corners, all in the same town and range, may be recorded
on this certificate.

A. Description of original monument and accessories and/or subsequent restoration:

(I10) Quarter corner common to Sections 26 and 27. 1986 - Reestablished by Stephen D. Douglas,
Cadastral Surveyor, for the U.S. D.O.I. Bureau of Land Management in a dependent resurvey of this
township. Reestablished the corner position midway and on the Section line between Section corners
40.145 chains north and south. The position was not monumented.

(6-Sec. 27) Northeast 1/16 corner, Section 27. Not established in the original survey.

B. Description of corner evidence found and/or method applied in restoring or reestablishing corner:

(I10) Reestablished the 1986 position midway and on the Section line between Section corners 2649.23'
(40.140 chains) north and south. The position for one of the controlling Section corners, I11, is
not monumented. Its position was computed by proportionate measurement to the dimensions given on the
1986 Plat of Resurvey between Quarter corners 1/2 mile East, South, and West, and Section corner 1
mile north.

(6-Sec. 27) Established the corner at the intersection of straight lines connecting opposite 1/16
corners.

C. Description of monument for corner and accessories established to perpetuate locating the position of the corner:


(I10) Set 1"IDx32" I.pipe with 4" alum. MDNR cap.
Set measuring nail with MDNR tag in the side of:
4" Spruce N45E 16.6' mrkd "1/4S NBT"
8" Maple S29E 2.0' do
6" Balsam S25W 24.85' do
10" Maple N19W 39.15' do
Set sq'd Cedar post adjacent.
Bearings are magnetic.

(6) Set 1"IDx32" I.pipe with 4" alum. MDNR cap.
Set measuring nail with MDNR tag in the side of:
4" Sugar N31E 13.2' mrkd "1/16S BT"
9" Maple in clump N77E 1.7' do
9" Maple S42W 23.6' do
4" Maple N41W 14.3' do
Set sq'd Cedar post adjacent.
Bearings are magnetic.

Signed by Stephan J. Szyszkoski
Surveyor's Michigan License No. 33986

Date 08/30/2011

For the Michigan Department of Natural Resources, Forest Management Division

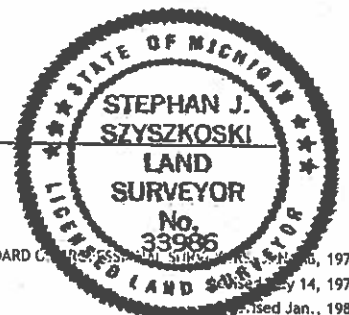

16707

16715