

SURVEY & REMONUMENTATION

BARRY COUNTY REMONUMENTATION

JUL 24 1997

LAND CORNER RECORDATION CERTIFICATE
Filing Requirement of Act 74, Mich. P.A. 1970

COMMISSION

For Corners in BARRY Located In: Corner Code #
(county)

1. Public Land Survey T 1N R 10W F-11
1/4 CORNER COMMON T _____ R _____
TO SECTIONS 28 & 33 T _____ R _____
PRAIRIEVILLE TOWNSHIP T _____ R _____

2. Property Controlling S _____ T _____ R _____
In Section S _____ T _____ R _____

3. Miscellaneous S _____ T _____ R _____
Property in Sec. S _____ T _____ R _____

4. Lot No _____, Recorded Plat _____
5. Private Claims _____

I, **Brian Reynolds**, in a field survey on **5 AUGUST, 1996** do hereby certify that under requirements of P.A. 74, Michigan P.A. of 1970, the corner points mentioned in lines 1 and 2 above were in conformance with regulations and rules therefore as required in the current manual of survey instructions of the United States Department of the Interior, Bureau of Land Management or by a decree of a Court of Law and/or that the corner points mentioned in lines 3, 4, and 5 above were in conformance with the rules of the Michigan Board of Land Surveyors or by a Decree of a Court of Law; established, re-established, monumented, re-monumented, recovered, found as expressed below.

NOTE: Not more than 2 corners, all in the same town and range, may be recorded on this certificate.

A	B	C	D	E	F	G	H	I	J	K	L	M
2	6	5	4	3	2	1						
3												
4	7	8	9	10	11	12						
5												
6	18	17	16	15	14	13						
7												
8	19	20	21	22	23	24						
9												
10	30	29	28	27	26	25						
11												
12	31	32	33	34	35	36						
13												

A. Description of original monument and accessories and/or subsequent restoration:

1. GENERAL LAND OFFICE: SYLVESTER SIBLEY, D.S., 1826 (R10W, P.26) WEST CORRECTED 40.12 IN LAKE
2. COUNTY SURVEYOR RECORDS: JOHN CRESSY, OCT.-NOV., 1884 (L.2, P.256 RESURVEY) "PUT IN TILE ON EDGE OF LAKE ON TRUE LINE, TOOK BEARINGS" B. OAK 30 N83W 249 W. OAK 24 N27W 165
3. CONSUMERS POWER COMPANY: McPHERSON & McCOMBS, (NO DATE) FIELD BOOKS 976, 995, & 1010 "FOUND TILE, SET "T" IRON IN E & W FENCE" 20" BLACK OAK W1/4 44.7' 10" TW. WILLOW N10W 16.30'


NO OTHER RECORDED HISTORICAL INFORMATION AVAILABLE FOR THIS CORNER

B. Description of corner evidence found and/or method applied in restoring or reestablishing corner:

FOUND TILE WITH "T" IRON INSIDE THE TILE IN LINE WITH DECAYED FENCE RUNNING WEST AND EAST INTO THE LAKE. FOUND ONE WITNESS, WILLOW FROM #3 OF PART "A". DISTANCE TO RESTORED POSITION AT E-11 CONFORMS CLOSELY WITH DISTANCE RECORDED BY CRESSY 2657.82', MEASURED 2658.15'. ACCEPTED FOUND TILE AS CORNER BY CRESSEY. REPLACED "T" IRON WITH STANDARD BARRY COUNTY REMONUMENTATION MONUMENT INSIDE OF FOUND TILE.

C. Description of monument for corner and accessories established to perpetuate locating the position of the corner:

SET STANDARD BARRY COUNTY REMONUMENTATION MONUMENT (WITH ALUMINUM CAP)
SET 20d NAIL W/REMON TAG IN THE EAST SIDE OF A 4" WILLOW N7°E 10.88'
SET 20d NAIL W/REMON TAG IN THE EAST SIDE OF A 14" WILLOW N13°W 20.26'
SET 20d NAIL W/REMON TAG IN THE SOUTH SIDE OF A 12" OAK N64°W 57.45'
SET 20d NAIL W/REMON TAG IN THE TOP CENTER OF A CUT STUMP N88°E 17.5'
1/2" CAPPED IRON (REYNOLDS 31602) N5°47'59"W 140.73'
CORNER LIES 20' +/- WEST OF THE SHORE OF MILLER LAKE
IN A DECAYING FENCE LINE (MOSTLY DOWN) RUNNING WEST AND EAST

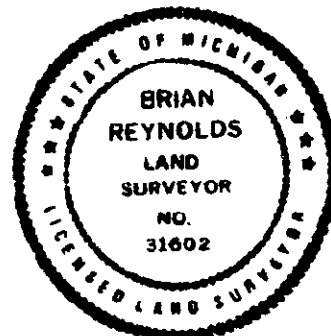

ACT 345 BARRY COUNTY REMONUMENTATION
APPROVED BY PEER REVIEW AT A MEETING HELD ON

7-8-96
BRIAN REYNOLDS

BR
COUNTY SURVEYOR

Signed by Brian Reynolds
Surveyor's Michigan License No 31602

Date May 16, 1997