

BARRY COUNTY REMONUMENTATION

LAND CORNER RECORDATION CERTIFICATE
Filing Requirement of Act 74, Mich. P.A. 1970

SURVEY &
REMONUMENTATION

APR 04 2000

For Corners in BARRY Located In: Corner Code #
(county)

1. Public Land Survey
¼ CORNER COMMON TO
SECTIONS 25 & 36
MAPLE GROVE TOWNSHIP

T 2N R 7W L-11
T R
T R
T R



2857
Page: 1 of 1
12/27/1999 01:44P

Daria K. Burghdoff- Barry Co. LCROR

2. Property Controlling S T R
in Section S T R

3. Miscellaneous S T R

4. Lot No , Recorded Plat
5. Private Claims

Register of Deeds Stamp & File Number

I, Brian Reynolds, in a field survey on 09 JULY, 1999 do hereby certify that under requirements of P.A. 74, Michigan P.A. of 1970, the corner points mentioned in lines 1 and 2 above were in conformance with regulations and rules therefore as required in the current manual of survey instructions of the United States Department of the Interior, Bureau of Land Management or by a decree of a Court of Law and/or that the corner points mentioned in lines 3, 4, and 5 above were in conformance with the rules of the Michigan Board of Land Surveyors or by a Decree of a Court of Law; established, re-established, monumented, re-monumented, recovered, found as expressed below.

NOTE: Not more than 2 corners, all in the same town and range, may be recorded on this certificate.

	A	B	C	D	E	F	G	H	I	J	K	L	M
1													
2	8		5		4		3		2		1		
3													
4	7		8		9		10		11		12		
5													
6	18		17		16		15		14		13		
7													
8	19		20		21		22		23		24		
9													
10	30		29		28		27		26		25		
11													
12	31		32		33		34		35		36		
13													

- A. Description of original monument and accessories and/or subsequent restoration:
1. GENERAL LAND OFFICE: MUSGROVE EVANS, D.S., 1826 (R7W, P.57) Be. 9 S05W 30 LYNN 36 N32W 15
2. COUNTY SURVEYOR RECORDS: SETH PRATT, 1887 (L.1, P.324) "STAKE & 3 STONES"
MAPLE 14 S72 ½E 68 ½ BLUE ASH 8 N63 ½E 1.03 ELM 14 S83 ½E 1.11

*** NO OTHER HISTORICAL INFORMATION, PUBLIC OR PRIVATE, AVAILABLE FOR THIS CORNER ***

B. Description of corner evidence found and/or method applied in restoring or reestablishing corner:


FOUND NO MAGNETIC EVIDENCE OF CORNER POSITION. EXCAVATED ON CENTERLINE OF EAST-WEST GRAVEL ROAD IN LINE WITH FENCE LINES NORTH-SOUTH. AT A DEPTH OF 1.5'± FOUND REMAINS OF A ROTTED WOOD STAKE SURROUNDED BY 3, 8"-12+" STONES.
ACCEPTED FOUND ROTTED WOOD STAKE SURROUNDED BY STONES AS PERPETUATION OF CORNER BY COUNTY SURVEYOR SETH PRATT.
REPLACED ROTTED WOOD STAKE WITH STANDARD BARRY COUNTY REMONUMENTATION MONUMENT.

C. Description of monument for corner and accessories established to perpetuate locating the position of the corner:
SET STANDARD BARRY COUNTY REMONUMENTATION MONUMENT (¾" X 36" IRON) WITH ALUMINUM CAP.
TOP CENTER OF A 12" X 12" X 4' CONCRETE FENCE CORNER POST N00°W 23.44'
SET 20d NAIL W/PLASTIC TAG IN THE NORTHWEST SIDE OF A 48" OAK N35°E 31.07'
SET 20d NAIL W/PLASTIC TAG IN THE NORTHWEST SIDE OF A 36" OAK N35°E 39.26'
SET 20d NAIL W/PLASTIC TAG IN THE SOUTHEAST SIDE OF A 10" ASH N70°E 83.06'

ACT 345 BARRY COUNTY REMONUMENTATION
APPROVED BY PEER REVIEW AT A MEETING HELD ON

12 July 99
BRIAN REYNOLDS

COUNTY SURVEYOR

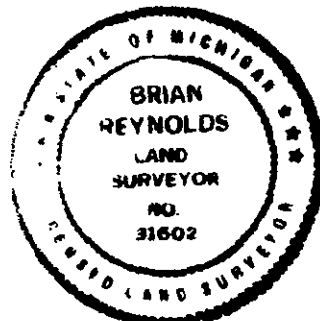

Signed by Brian Reynolds
Surveyor's Michigan License No 31602

Date Dec 27, 1999