

# SURVEY & REMONUMENTATION

## BARRY COUNTY REMONUMENTATION LAND CORNER RECORDATION CERTIFICATE Filing Requirement of Act 74, Mich. P.A. 1970

FEB 03 1999

For Corners in **SECTION** Located In: Corner Code #  
**BARRY**  
(county)

1. Public Land Survey T 2N R 8W A-9  
CORNER COMMON TO T      R       
SECTIONS 19 AND 30 ON T      R       
RANGE LINE T      R       
BALTIMORE TOWNSHIP  
2. Property Controlling S      T      R       
in Section S      T      R       
3. Miscellaneous S      T      R

4. Lot No     , Recorded Plat       
5. Private Claims

I, Brian Reynolds, in a field survey on 13 JULY, 1998 do hereby certify that under requirements of P.A. 74, Michigan P.A. of 1970, the corner points mentioned in lines 1 and 2 above were in conformance with regulations and rules therefore as required in the current manual of survey instructions of the United States Department of the Interior, Bureau of Land Management or by a decree of a Court of Law and/or that the corner points mentioned in lines 3, 4, and 5 above were in conformance with the rules of the Michigan Board of Land Surveyors or by a Decree of a Court of Law; established, re-established, monumented, re-monumented, recovered, found as expressed below.  
NOTE: Not more than 2 corners, all in the same town and range, may be recorded on this certificate.



**2745**  
Page: 1 of 1  
12/17/1998 12:35P

Register of Deeds Stamp & File Number

	A	B	C	D	E	F	G	H	I	J	K	L	M
1													
2	6		5		4		3		2		1		
3													
4	7		8		9		10		11		12		
5													
6	18		17		16		15		14		13		
7													
8	19		20		21		22		23		24		
9													
10	30		29		28		27		26		25		
11													
12	31		32		33		34		35		36		
13													


- A. Description of original monument and accessories and/or subsequent restoration:  
1. GENERAL LAND OFFICE DEPUTY SURVEYOR MUSGROVE EVANS, 1826, "76.96 WEST BOUNDARY 14 NORTH OF POST, SET POST FOR CORNER. A Be 12 S31E 51 W. Oak 20 N40E 48 links  
2. NO RECORD OF THIS CORNER CAN BE FOUND IN THE COUNTY SURVEYOR RECORDS

\*\*\* NO OTHER HISTORICAL INFORMATION, PUBLIC OR PRIVATE, AVAILABLE FOR THIS CORNER \*\*\*

B. Description of corner evidence found and/or method applied in restoring or reestablishing corner:  
NO DIRECT EVIDENCE OF CORNER MONUMENTATION WAS FOUND. SET CORNER AT 14 LINKS (9.24 FEET) NORTH OF M-9 T2N R9W AND ON LINE BETWEEN A-9 AND A-8, BOTH PREVIOUSLY PEER APPROVED AND REMONUMENTED. EXCAVATION AT THIS SITE WAS PERFORMED IN 1993 AT THE REQUEST OF THE REMONUMENTATION PEER GROUP AS A CONDITION OF THE APPROVAL OF M-9 T2N, R9W, WHICH WAS APPROVED AND REMONUMENTED AT THAT TIME. THE 1993 EXCAVATION AT A-9 REVEALED NO EVIDENCE OF CORNER MONUMENTATION. SET STANDARD BARRY COUNTY REMONUMENTATION MONUMENT.

C. Description of monument for corner and accessories established to perpetuate locating the position of the corner:  
SET STANDARD BARRY COUNTY REMONUMENTATION MONUMENT (3/4" X 36" IRON) WITH ALUMINUM CAP.  
SET 20d NAIL W/PLASTIC TAG IN THE SOUTHWEST SIDE OF AN 8" WALNUT S37°E 53.66'  
SET 20d NAIL W/PLASTIC TAG IN THE WEST SIDE OF A 36" OAK S03°W 32.50'  
SET 20d NAIL W/PLASTIC TAG IN THE NORTH SIDE OF A 30" WALNUT S61°W 54.66'  
SET 20d NAIL W/PLASTIC TAG IN THE SOUTHWEST SIDE OF A 20" WALNUT N79°W 49.05'  
M-9, T2N, R9W, BARRY COUNTY MONUMENT LIES SOUTH 9.24'

ACT 345 BARRY COUNTY REMONUMENTATION  
APPROVED BY PEER REVIEW AT A MEETING HELD ON  
13 July, 98 BR  
BRIAN REYNOLDS COUNTY SURVEYOR

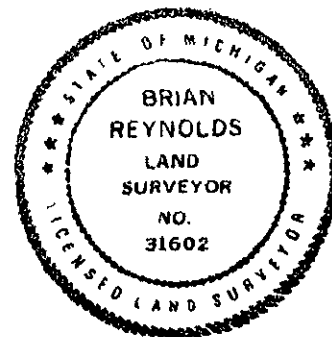

Signed by BR  
Surveyor's Michigan License No 31602

Date DEC 15, 1998  
FORM APPROVED BY MICHIGAN STATE BOARD OF LAND SURVEYORS. JAN. 28, 1971  
REVISED MAY 14, 1975 REVISED JANUARY, 1983 REVISED OCTOBER 1985