

# SURVEY & REMONUMENTATION

1993

## COMMISSION

### BARRY COUNTY REMONUMENTATION LAND CORNER RECORDATION CERTIFICATE Filing Requirement of Act 74, Mich. P.A. 1970

STATE OF MICHIGAN  
COUNTY OF BARRY  
RECEIVED FOR RECORD

JUL 20 11 20 AM '93

Sandy Schendelmar  
REGISTER OF DEEDS

For corners in

BARRY  
(County)

Located In:

Corner Code #

1. Public Land Survey T 2N R 9W E-8  
T HOPE TWP  
T HOPE TWP  
T HOPE TWP
2. Property Controlling S HOPE TWP T HOPE TWP R HOPE TWP  
in Section S HOPE TWP T HOPE TWP R HOPE TWP
3. Miscellaneous S HOPE TWP T HOPE TWP R HOPE TWP  
Property in Sec. S HOPE TWP T HOPE TWP R HOPE TWP

002037

Register of Deeds Stamp & File Number

4. Lot No. HOPE TWP, Recorded Plat HOPE TWP
5. Private Claims HOPE TWP

I, Brian Reynolds, in a field survey on May, 19 93, do hereby certify that under requirements of P.A. 74, Michigan P.A. of 1970, the corner points mentioned in lines 1 and 2 above were in conformance with regulations and rules therefore as required in the current manual of survey instructions of the United States Department of the Interior, Bureau of Land Management or by a decree of a Court of Law and/or that the corner points mentioned in lines 3, 4 and 5 above were in conformance with the rules of the Michigan Board of Land Surveyors or by a Decree of a Court of Law; established, re-established, monumented, re-monumented, recovered, found as expressed below:

**NOTE: Not more than 4 corners, all in the same town and range, may be recorded on this certificate.**

#### A. Description of original monument and accessories and/or subsequent restoration:

##### General Land Office

A W. Oak 28 N2°W 23

A B. Oak 6 S5°W 43

##### Road Commission (5/21/74)

Found 1" pipe, brick & crockery

N&T Hickory 15" N13½°W 33.00'

N&T Cherry 5" S69½°W 8.2'

Donald L. Bissell (March, 1974) LCRC#119

Found 1" pipe, brick & crockery in N-S fence line; Old witnesses from plat of Cloverdale (1887) still standing, but rotten: 28" Hickory N13½°E 8'

30" Hickory S3¼°E 39'. New Witnesses;

N.B.T. Hickory 15" N13°30'W, 33.0'

N.B.T. Cherry 5" S69°30'W, 8.2'

Part "A" continued on back of form

#### B. Description of corner evidence found and/or method applied in restoring or reestablishing corner:

Found 1" pipe with brick and crockery and following witnesses:

Nail in S'yly side of 10" Cherry S70°E 8.36'

Nail in W'yly side of 10" Cherry N30°W 18.36'

Nail in SE'yly side of 4" Ash N80°W 12.25'

#### C. Description of monument for corner and accessories established to perpetuate locating the position of the corner:


Set Standard 3/4"x24" remonumentation iron and Aluminum cap

To the above witnesses add:

40d nail and witness tag in NW side of 4" Ash S20°W 27.98'

40d nail and witness tag in SW side of 6" Ash S20°E 17.48'

40d nail and witness tag in SE side of 6" Ash S30°W 20.65'

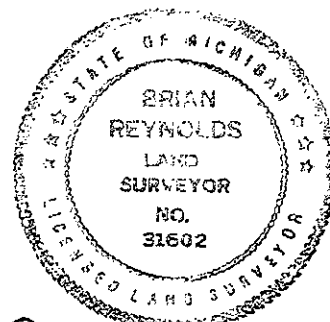

Signed by

*[Signature]*

Date

7-13-93

Surveyor's Michigan License No.

31602

Land Corner Recordation Certificate #422 (November, 1990) by Reynolds

Found 1" pipe with brick and crockery in N-S fence

Found N.B.T. Cherry 5" S69°30'E 8.2'

New witnesses:

8" Cherry S70°E 8.32'

6" Hickory N70°W 12.22'

7" Cherry N30°W 18.10'