

REMONUMENTATION

APR 08 1996

COMMISSION

Barry County Remonumentation
LAND CORNER RECORDATION CERTIFICATE
Filing Requirement of Act 74, Mich. P.A. 1970

STATE OF MICHIGAN
COUNTY OF BARRY
RECEIVED FOR RECORD

Nov 20 9 08 AM '95

Sandra Schondelmar
REGISTER OF DEEDS

002327

other code #1

Register of Deeds Stamp & File Number

For corners in

Barry

(County)

Located In:

Corner Code #

1. Public Land Survey T R
T R
T R
T R
2. Property Controlling S 6 T 2N R 10W ORANGEVILLE
in Section S 31 T 3N R 10W Yankee Springs Twp.
3. Miscellaneous S T R
Property in Sec. S T R
4. Lot No. , Recorded Plat
5. Private Claims

I, John C. Bueche, in a field survey on September, 19 95, do hereby certify that under requirements of P.A. 74, Michigan P.A. of 1970, the corner points mentioned in lines 1 and 2 above were in conformance with regulations and rules therefore as required in the current manual of survey instructions of the United States Department of the Interior, Bureau of Land Management or by a decree of a Court of Law and/or that the corner points mentioned in lines 3, 4 and 5 above were in conformance with the rules of the Michigan Board of Land Surveyors or by a Decree of a Court of Law; established, re-established, monumented, re-monumented, recovered, found as expressed below:


NOTE: Not more than 4 corners, all in the same town and range, may be recorded on this certificate.

A. Description of original monument and accessories and/or subsequent restoration:

3/4" pipe as per survey Jan., 1993 by Reynolds, not recorded
SW cor. fnd. N 44.94' Meander post noted by GLO Deputy Surveyor,
NW cor. fnd. E 40.08' John Mullett, January 16, 1826
Deciduous tree SW 4.31 12.93 chains W of C-13 (853.38')
Fir tree W 10.44 As "Y Oak 12 on margin of the Lake"

B. Description of corner evidence found and/or method applied in restoring or reestablishing corner:


Found 3/4" pipe as per survey 856.55' West of SE cor. 31, 3-10
SW cor. fnd. N 44.94'
NW cor. fnd. E 40.08'

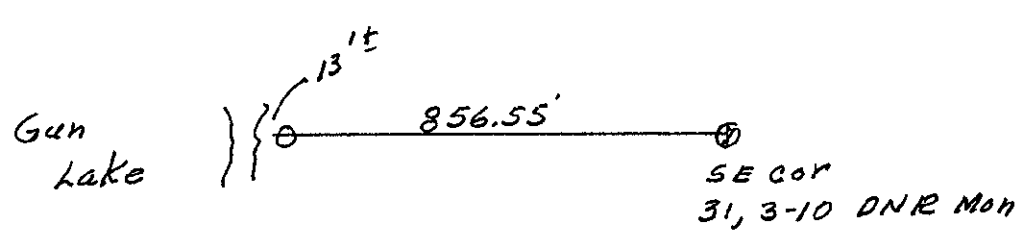

C. Description of monument for corner and accessories established to perpetuate locating the position of the corner:

Placed Barry Co. Cap on top 3/4" pipe
NW cor. hse. fnd. #4048 S 75 E 40.08'
SW cor. hse. fnd. #3982 N 0 E 44.94'
SW cor. hse. frame #4048 S 45 E 49.69'
Fence E-W, South 0.8'±
E. edge Lake West 13'±

ACT 345 BARRY COUNTY REMONUMENTATION
APPROVED BY PEER REVIEW AT A MEETING HELD ON
August 14, 1995 BR
BRIAN REYNOLDS COUNTY SURVEYOR

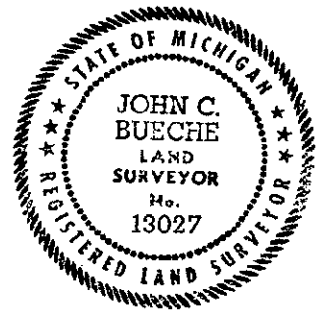

Signed by John C. Bueche
Surveyor's Michigan License No. 13027

Date Oct 2, 1995