

BARRY COUNTY REMONUMENTATION

LAND CORNER RECORDATION CERTIFICATE
Filing Requirement of Act 74, Mich. P.A. 1970

STATE OF MICHIGAN
COUNTY OF BARRY
RECEIVED

MAR 5 9 25 AM '97

Sandy Schumacher
REGISTER OF DEEDS

002470

Register of Deeds Stamp & File Number

For Corners in BARRY Located in: Corner Code #
(county)

1. Public Land Survey T R
PROPERTY CONTROLLING T R
CORNER BETWEEN T R
A-10 AND A-11 T R
CASTLETON TOWNSHIP

2. Property Controlling S 30 T 3N R 7W #1
in Section S 25 T 3N R 8W

3. Miscellaneous S T R
Property in Sec. S T R

4. Lot No. Recorded Plat
5. Private Claims

I, Brian Reynolds, in a field survey on 7 NOVEMBER, 1996 do hereby certify that under requirements of P.A. 74, Michigan P.A. of 1970, the corner points mentioned in lines 1 and 2 above were in conformance with regulations and rules therefore as required in the current manual of survey instructions of the United States Department of the Interior, Bureau of Land Management or by a decree of a Court of Law and/or that the corner points mentioned in lines 3, 4, and 5 above were in conformance with the rules of the Michigan Board of Land Surveyors or by a Decree of a Court of Law, established, re-established, monumented, re-monumented, recovered, found as expressed below.

NOTE: Not more than 2 corners, all in the same town and range, may be recorded on this certificate.

	A	B	C	D	E	F	G	H	I	J	K	L	M
2	6	5	4	3	2	1							
3													
4	7	8	9	10	11	12							
5													
6	18	17	16	15	14	13							
7													
8	19	20	21	22	23	24							
9													
10	30	29	28	27	26	25							
11													
12	31	32	33	34	35	36							
13													

A. Description of original monument and accessories and/or subsequent restoration:


1. GENERAL LAND OFFICE, LUCIUS LYON, D.S. SURVEY OF THE LINE BETWEEN RANGES 7 AND 8 WEST "30.95 SYCAMORE 15 INCHES DIAM FRACL CORNER ON SOUTH SIDE OF LAKE..."
2. NO MENTION OF THIS CORNER COULD BE FOUND IN THE RECORDS OF THE COUNTY SURVEYOR.
3. ACT 132 SURVEY: BY JAMES L. KING, P.S. #14766, DECEMBER, 1977 (L.1, P.468), SHOWS A-10 AND TWO IRONS AT PROPERTY CORNERS ALONG RANGE LINE, NO MONUMENT OR WITNESSES SHOWN TO CONTROL LOCATION OF RANGE LINE NORTH OF A-10.
4. COMPUTING SHEET FROM SURVEY BY KING INDICATES THE RANGE LINE DEFINED BY A-11 T3N R7W AND 2" PIPE AT INTERSECTION OF RANGE LINE AND THE NORTH LINE OF THE PENN CENTRAL RAILROAD RIGHT OF WAY.

B. Description of corner evidence found and/or method applied in restoring or reestablishing corner:

FOUND A-11 T3N R7W BY KING, PROPERTY CORNERS ON RANGE LINE BY KING, AND 2" PIPE AT RANGE LINE AND RAILROAD RIGHT OF WAY, ALL CONSISTENT WITH EACH OTHER. EXTENDED LINE FROM A-10 THROUGH IRON PIPE TO THE SOUTH SHORE OF THORNAPPLE LAKE. SET STANDARD BARRY COUNTY REMON IRON AND CAP ON RANGE LINE SEVERAL FEET SOUTH OF THE SHORE OF THORNAPPLE LAKE.

C. Description of monument for corner and accessories established to perpetuate locating the position of the corner:

SET STANDARD BARRY COUNTY REMONUMENTATION MONUMENT (3/4"X36" SOLID IRON W/ALUMINUM CAP)
SET 40d NAIL W/REMON TAG IN THE EAST SIDE OF A UTILITY POLE S48°E 64.62'
SOUTHWEST CORNER HOUSE FOUNDATION S88°E 51.51'
NORTHWEST CORNER HOUSE FOUNDATION N65°E 36.64'
CONCRETE PLAT MONUMENT N31°E 130.34'
CONCRETE PLAT MONUMENT S72°W 88.00'
CONCRETE PLAT MONUMENT S15°E 135.01'

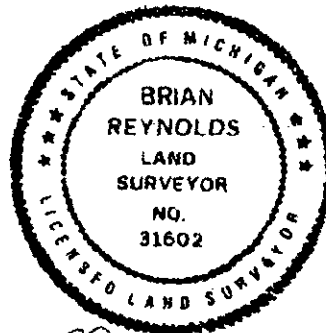

Signed by [Signature]
Surveyor's Michigan License No 31602

Date FEB 18, 1997

FORM APPROVED BY MICHIGAN STATE BOARD OF LAND SURVEYORS, JAN. 28, 1971
REVISED MAY 14, 1975 REVISED JANUARY, 1983 REVISED OCTOBER 1995

ACT 345 BARRY COUNTY REMONUMENTATION
APPROVED BY PEER REVIEW AT A MEETING HELD ON

18 NOV. '96 BR

JUL 24 1997