

MAR 31 1994

LAND CORNER RECORDATION CERTIFICATE

FILING REQUIREMENT OF ACT 74, MICH. P.A.1970
BAY COUNTY REMONUMENTATION PROJECT - 1993

FOR CORNERS OF--:	LOCATED IN--:	CORNER CODE NUMBER
1. PUBLIC LAND SURVEY_____	T. <u>13</u> N. S., R. <u>6</u> E. W.	<u>M-10</u>
2. PROPERTY CONTROLLING IN SECTION _____	, T. _____ N. S., R. _____ E. W.	_____
3. MISCELLANEOUS PROPERTY IN SECTION _____	, T. _____ N. S., R. _____ E. W.	_____
4. LOT NO. _____, RECORDED PLAT _____		
5. PRIVATE CLAIMS _____		

LIBER **003** PAGE **72**

JAN 27 1 46 PM '94

RECORDED

REGISTER OF DEEDS
BAY COUNTY, MICHIGAN

REGISTER OF DEEDS STAMP AND
FILING NUMBER

I, Duane F. Ledy, do hereby certify that under requirements of P.A. 74, Michigan P.A. of 1970, the corner points mentioned in lines 1 and 2 above were, in a field survey on DECEMBER 27, 1993, established, re-established, monumented, re-monumented, recovered or restored as expressed below and in conformance with regulations and rules therefore as required in the current manual of survey instructions of the United States Department of the Interior, Bureau of Land Management or by a decree of a court of law. Furthermore, that the corner points mentioned in lines 3, 4 and 5 above were, in a field survey on _____, 19____, found, recovered, restored, established or re-established as expressed below and in conformance with the rules of the Michigan State Board of Registration for Land Surveyors or, by a Decree of a Court of law:

A. Description of original monument and accessories and/or subsequent restoration:

J. Wampler set post in 1821 at 40.00 chains North of M-11. Tuscola County Surveyor, L. Brumley, set post at mid-point between M-11 and M-9.


B. Description of corner evidence found and/or method applied in restoring or re-establishing corner:

No corner found; Set corner position at mid-point on line between M-9 and M-11; Corner position accepted by Bay County Peer Review Group and ratified December 9, 1993.

C. Description of monument for corner and accessories established to perpetuate locating the position of the corner:

Set 5/8" rod and Bay County brass cap in monument box.

S 45° E	- 12.92'	PK Nail & Tag at edge of Pavement
S 45° W	- 15.58'	PK Nail & Tag at edge of Pavement
N 45° E	- 20.06'	SE corner of concrete headwall
N 45° W	- 19.35'	SE corner of concrete headwall
West	- 2.0'	Centerline of Reese Road

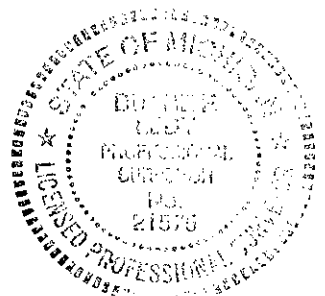

SIGNED BY Duane F. Ledy DATE January 13, 1994

SURVEYOR'S MICHIGAN REGISTRATION NO. 21575 (SEAL)

FOR STATE AND UNITED STATES AGENCIES:

SIGNED BY _____ DATE _____

CHIEF OF SURVEY PARTY

APPROVED AND SIGNED BY _____ DATE _____

MICHIGAN REGISTERED LAND SURVEYOR (SEAL)

SURVEYOR'S MICHIGAN REGISTRATION NO. _____