

## SECTION

**BAY COUNTY REMONUMENTATION  
LAND CORNER RECORDATION CERTIFICATE  
Filing Requirement of Act 74, Mich. P.A. 1970**

For corners in

BAY COUNTY

(County)

Located In:

Corner Code #

## 1. Public Land Survey

T 14N R 5EPC #11T RT RT R2. Property Controlling  
in SectionS27&28T RS T R3. Miscellaneous  
Property in Sec.ST RST R

*Robert James MacFarlane*  
REGISTER OF DEEDS  
BAY COUNTY, MICHIGAN

2000 JAN -7 P 2:01

RECORDED

Register of Deeds Stamp &amp; File Number

## 4. Lot No. \_\_\_\_\_, Recorded Plat \_\_\_\_\_

## 5. Private Claims \_\_\_\_\_

I, DALE L. WINIECKE, in a field survey on NOVEMBER 11, 1999 do hereby state that under requirements of P.A. 74, Michigan P.A. of 1970, the corner points mentioned in lines 1 and 2 above were in conformance with regulations and rules therefore as required in the current manual of survey instructions of the United States Department of the Interior, Bureau of Land Management or by a decree of a Court of Law and /or that the corner points mentioned in lines 3, 4 and 5 above were in conformance with the rules of the Michigan Board of Land Surveyors or by a Decree of a Court of Law; established, re-established, monumented, recovered, found as expressed below:

NOTE: Not more than 2 corners, all in the same Town and Range, may be recorded on this certificate.

	A	B	C	D	E	F	G	H	I	J	K	L
1												
2		6		5		4		3		2		1
3												
4		7		8		9		10		11		12
5												
6		18		17		16		15		14		13
7												
8		19		20		21		22		23		24
9												
10		30		29		28		27		26		25
11												
12		31		32		33		34		35		36
13												

## A. Description of original monument and accessories and/or subsequent restoration:

PC #11  
CORNER NORTH OF G-10 (CORNER IS AT THE SOUTH LINE OF JOHN RILEY RESERVE)  
POST SET BY J. MULLETT, JUNE 1839  
10" TAMARACK S56°W, 2.3 CHAINS  
6" PINE N81°E, 33 LINKS

-C.E. JENNISON'S SECOND ADDITION, L. 1, P. 34 BAY COUNTY RECORDS.

## B. Description of corner evidence found and/or method applied in restoring or reestablishing corner:

PC #11  
CORNER NORTH OF G-10 (CORNER IS AT THE INTERSECTION OF THE SOUTH LINE OF JOHN RILEY RESERVE AND THE EAST LINE OF SECTION 28, T14N, R5E).  
SEARCHED THE APPARENT LOCATION OF THE CORNER AND FOUND NO MONUMENTATION  
CORNER RESET BY RETRACING THE CENTERLINE OF COLUMBUS AVENUE RIGHT-OF-WAY (SOUTH SECTION LINE) AND INTERSECTING SAID CENTERLINE WITH THE EAST LINE OF C.E. JENNISON'S SECOND ADDITION.

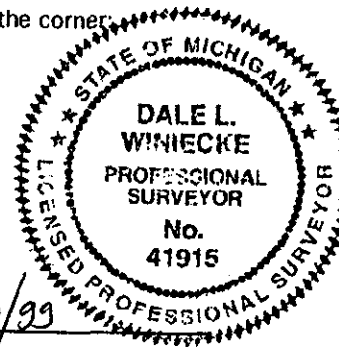
## C. Description of monument for corner and accessories established to perpetuate locating the position of the corner:

PC #11  
CORNER NORTH OF G-10  
SET 5/8" x 24" REROD WITH BAY COUNTY REMONUMENTATION CAP IN MONUMENT BOX.  
N 20°E 30.13' TO SET MAG NAIL IN EAST FACE 10" OAK.  
N 40°E 43.60' TO SET MAG NAIL IN NW FACE UTILITY POLE.  
S 5°E 55.25' TO SET MAG NAIL IN WEST FACE 6"X 6" WOOD POST.  
S 45°E 42.05' TO SET NAIL IN SE FACE 6" OAK.  
POINT FALLS ON THE PHYSICAL CENTERLINE OF COLUMBUS AVENUE AND ±130 EAST OF LINCOLN STREET.

Signed by

*Dale L. Winiecke*

Date

*12/30/99*Surveyor's Michigan License No. 41915

FB W-T 1999, P. 23

FORM APPROVED BY MICHIGAN STATE BOARD OF PROFESSIONAL SURVEYORS, JAN. 28, 197  
REVISED MAY 14, 197  
REVISED JAN., 198  
REVISED OCT., 199

APPROVED LAND CORNER  
P.A. 345 OF 1990 - Bay County  
Date 11/18/99  
*MM*  
Michael MacDonald P.S.  
County Representative

005

15