RAMMED BY THE BURRIEN COUNTY SURVEY PEER GROUP AS THE OFFICIAL CORNER LINDER MICHIGAN PUBLIC ACT/

BERRIEN COUNTY REMONUMENTATION

11142012

177

CIRNER longali. Signil platos del

\$9.00

117 m

LAND CORNER RECORDATION CERTIFICATE: /29/33


Filing Requirement of Act 74, Mich. P.A. 1970

_	BERRIEN (County)	Located In:	Corner Code ##	RECORDED
1.	Public Land Survèy	T R T R T R T R	Other	Key 29 3 40 PM 195
2.	Property Controlling in Section	S _6 _ T _4S _ R 18W _ S T R	#1	REDISTER OF METERS
3.	Miscellaneous Property in Sec.	S T R S T R		REGISTER OF THE US T Register of Deeds Stamp & File Number
4. 5.	Lot No, Private Claims,	Recorded Plat		A B C D E F G H I J K L

JOHN G. KAMER _ , in a field survey on ___NOVEMBER 15 do hereby certify that under requirements of P.A. 74, Michigan P.A. of 1970, the corner points mentioned in lines 1 and 2 above were in conformance with regulations and rules therefore as required in the current manual of survey instructions of the United States Department of the Interior, Bureau of Land Management or by a decree of a Court of Law and/or that the corner points mentioned in lines 3, 4 and 5 above were in conformance with the rules of the Michigan Board of Land Surveyors or by a Decree of a Court of Law; established, re-established, monumented, re-monumented, recovered, found as expressed below:

NOTE: Not more than 4 corners, all in the same town and range, may be recorded on this certificate.

A. Description of original monument and accessories and/or subsequent restoration: (SEE BACK.)

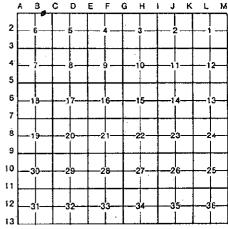

SYSWEY & MOTENTAL !

MAR 2 7 1996

COMMISSION

B. Description of corner evidence found and/or method applied in restoring or reestablishing corner:

FOUND STONE WITH POINTED TOP AS REFERENCED IN NOTES FROM EARLY 1900'S THROUGH 1940'S±. DISTANCE CHECKED TO NE CORNER SECTION 6. STONE WAS 12" DEEP AND APPEARED UNDISTURBED AND COVERED BY A 14" X 8" X 6" PIECE OF OLD CONCRETE.

Description of monument for corner and accessories established to perpetuate locating the position of the corner:

REMOVED LARGE STONE WITH POINTED TOP.

REMOVED LARGE STONE WITH POINTED TOP.

SET STANDARD 3' X 4" CONCRETE MONUMENT WITH BRASS PLATE. ALSO SET CARSONITE MARKER IN VICINITY OF CORNER.

SET NAIL W/TAG IN PP 576° W 34.98'

SET NAIL W/TAG IN 24" LOCUST N8° W 51.83'

SET NAIL W/TAG IN 10" MULBERRY N50° W 26.18'

TOP BOLT ON FIRE HYDRANT 550° E 89.08'

THIS POSITION NOT ESTABLISHED BY ORIGINAL GOVERNMENT SURVEYORS. THIS MONUMENT IS ACCEPTED AS THE BEST AVAILABLE ENTIRED OF THE POSITION OF THE CORNER. AVAILABLE EVIDENCE OF THE POSITION OF THE CORNER.

OF MICHIGAN STATE OF MICHIES JOHN G. KAMER
LAND SURVEYOR 27449 27449 CAND SURVEY No. THEO LAND SURVEY

Signed by .

License No. Surveyor's Michigan

LIBER

3PAGE

FORM APPROVED BY MICHIGAN STATE BOARD OF LAND SURVEYORS, JAN. 28, 1971

REVISED MAY 14, 1975 REVISED JAN., 1983

Benton Township (T 4 S, R 18 W) Property Control Corner 757' West of NE Cor. Sec. 6

Early 1900's

Hemmingway Notes @ W&A

Stone Centerline Lakeshore & N. Line of Sec. 758' (757.3') W. of NE Cor. (125.4' log)

March 29, 1925

J.H. Dewey

Stone 759' W. of NE Cor.

May 4, 1927

W&A Notes

Stone 759' W. of NE Cor. on N. Line of Sec.

1928

W&A Notes

Stone 759' W. of NE Cor. (124.2' jog)

1940's±

W&A Notes (Dewey?)

Stone Centerline Lakeshore

758' (758.4') W of NE Cor. (125.4' jog)

June 25, 1985

Kamer W&A

Found Iron (ROW) 763.2' from NE Cor. 6-4-18

Nov. 20, 1990

Kamer W&A

Found Iron (ROW) 763.92' from NE Cor. 6-4-18:

?

George Mitchell

758.36' W. of NE Cor.

Feb. 28, 1995

Kamer W&A

Reference Cor. on the N. Line of Sec 6-4-18


Found Stone w/ Pointed Top

Covered by 14" x 8" x 6" Piece of Old Con.

Top Bolt of Hydrant S 54° E 89.00' Set PK in 24" Locust N 8° W 51.74' Set PK in 10" Mulberry N 55° W 26.48'

Set PK in PP S 74° W 34.98'

NOTE: FOUND STONE ON NORTH LINE SEC. 6-4-18 PER OLD NOTES CIRCA 1920 AND MAY 4, 1927 ON FILE AT MIGHTMAN & ASSOCIATES INC.

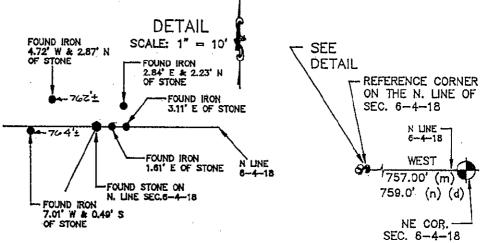

LIBER 3PAGE 307