

RATIFIED BY THE BERRIEN COUNTY
SURVEY PEER GROUP AS THE
OFFICIAL CORNER UNDER MICHIGAN
PUBLIC ACT 345 OF 1990

Charles W. Barger
10-23-97
For corners in

BERRIEN COUNTY REMONUMENTATION
LAND CORNER RECORDATION CERTIFICATE
Filing Requirement of Act 74, Mich. P.A. 1970

RECORDED

97 OCT 31 PM 2:04

BERNICE TRETHERWAY
REGISTER OF DEEDS
BERRIEN COUNTY, MICHIGAN

BERRIEN (County) Located In: Corner Code # E-1

1. Public Land Survey	T 7 R 19	E-1
	T R	
	T R	
	T R	
2. Property Controlling in Section	S T R	
	S T R	
3. Miscellaneous Property in Sec.	S T R	
	S T R	
4. Lot No. , Recorded Plat		
5. Private Claims		

10/31/97 111W2484 A99
CORNER \$9.00
10/31/97 111W2484 A99
Register of Deeds Stamp & File Number STATE REPLY FEE \$2.00

I, CHARLES W. BARGER in a field survey on OCTOBER, 19 97, do hereby certify that under requirements of P.A. 74, Michigan P.A. of 1970, the corner points mentioned in lines 1 and 2 above were in conformance with regulations and rules therefore as required in the current manual of survey instructions of the United States Department of the Interior, Bureau of Land Management or by a decree of a Court of Law and/or that the corner points mentioned in lines 3, 4 and 5 above were in conformance with the rules of the Michigan Board of Land Surveyors or by a Decree of a Court of Law; established, re-established, monumented, re-monumented, recovered, found as expressed below:

NOTE: Not more than 4 corners, all in the same town and range, may be recorded on this certificate.

	A	B	C	D	E	F	G	H	I	J	K	L	M
2	6		5		4		3		2		1		
3													
4	7		8		9		10		11		12		
5													
6	13		17		16		15		14		13		
7													
8	19		20		21		22		23		24		
9													
10	30		29		28		27		26		25		
11													
12	31		32		33		34		35		36		
13													

A. Description of original monument and accessories and/or subsequent restoration:

L. LYON N. BOUNDARY 1.24 E OF CORNER
FEB 1830 BEECH 12 S70E 38
SUGAR 6 S40W 21

SURVEY &
REMONUMENTATION

NOV 2 1 1997

COMMISSION


B. Description of corner evidence found and/or method applied in restoring or reestablishing corner:

C. BARGER FOUND RR SPIKE
1997 (SE 32-6-19) RR SPIKE W 81.65'
P.K. IN PP S31DEG16'E 42.09'
P.K. IN PP N76DEG48'W 125.00'
P.K. IN PP N74DEG24'E 107.38'

C. Description of monument for corner and accessories established to perpetuate locating the position of the corner:

E-1 1" PIPE 36" LONG WITH 2 1/2" REMONUMENTATION BRASS CAP IN MONUMENT BOX
2 1/2" REMONUMENT MARKER OVER 1" PIPE W 81.65'
WITNESS TAG IN PP S31DEG16'E 42.09'
WITNESS TAG IN PP N76DEG48'W 125.00'
WITNESS TAG IN PP N74DEG24'E 107.38'

AND IS ACCEPTED AS A CAREFUL AND FAITHFUL PERPETUATION OF THE POSITION OF TH ORIGINAL CORNER.

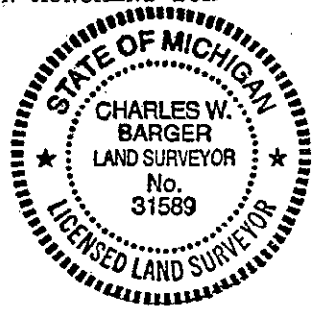

Signed by *Charles W. Barger* Date OCTOBER 31, 1997

Surveyor's Michigan License No. 31589

BARGER ENGINEERING, INC.
BERRIEN COUNTY REMONUMENTATION

NORTHWEST CORNER SECTION 4, TOWNSHIP 7 SOUTH, RANGE 19 WEST

(E-1)

L. Lyon
Feb 1830

N. Boundary 1.24 E of Corner
Beech 12 S70E 38
Sugar 6 S40W 21

R. Harner
1984

Ties to SE Cor Section 32-6-19
With Tie to 82.08' E

C. Barger
Nov 1996

Found RR Spike
(SE32-6-19) RR Spike W 81.65'
P.K. in PP S31deg16'E 42.09'
P.K. in PP N76deg48'W 125.00'
P.K. in PP N74deg24'E 107.38'

SURVEY &
REMONUMENTATION

NOV 21 1997

COMMISSION

JOB ASSIGNMENT 1996-02-0254

LIBER

4 PAGE

14