

RATIFIED BY THE BERRIEN COUNTY  
SURVEY PEER GROUP AS THE  
OFFICIAL CORNER UNDER MICHIGAN  
PUBLIC ACT 345 OF 1990

SEP 7, 1999  
*[Signature]*  
For corners in

BERRIEN  
(County)

Located In:

Corner Code #

LAND CORNER RECORDATION CERTIFICATE  
Filing Requirement of Act 74, Mich. P.A. 1970  
Berrien County Remonumentation

NOV -4 PM 3:23  
SERVICE TRETHERWAY  
REGISTER OF DEEDS  
BERRIEN COUNTY, MICHIGAN

1. Public Land Survey  
S 1/4 COR FRAC SEC. 24

T 8S R 18W L9

2. Property Controlling  
in Section

S T R

3. Miscellaneous  
Property in Sec.

S T R

11/04/99 111H7199 A55  
CORNER \$7.00  
11/04/99 111H7199 A55  
STATE REMON FEE \$2.00

Register of Deeds Stamp & File Number

4. Lot No. , Recorded Plat  
5. Private Claims

I, DALE L. KESLER, in a field survey on AUGUST 27, 1999 do hereby state that under requirements of P.A. 74, Michigan P.A. of 1970, the corner points mentioned in lines 1 and 2 above were in conformance with regulations and rules therefore as required in the current manual of survey instructions of the United States Department of the Interior, Bureau of Land Management or by a decree of a Court of Law and for that the corner points mentioned in lines 3, 4 and 5 above were in conformance with the rules of the Michigan Board of Land Surveyors or by a Decree of a Court of Law; established, re-established, monumented, recovered, found as expressed below:

NOTE: Not more than 2 corners, all in the same town and range, may be recorded on this certificate.

A. Description of original monument and accessories and/or subsequent restoration:

THIS CORNER WAS NOT ORIGINALLY SET BY THE GOVERNMENT SURVEYORS. THERE APPEARS TO BE NO RECORDED HISTORY OF THIS CORNER.

B. Description of corner evidence found and/or method applied in restoring or reestablishing corner:


FOUND NO EVIDENCE OF CORNER. SET CORNER MIDWAY BETWEEN THE SOUTHWEST CORNER OF SECTION 24 AND THE SOUTHEAST CORNER OF SECTION 24 AND ON LINE BETWEEN THE NORTHWEST CORNER OF SECTION 7, T38N, R2E INDIANA, AND THE SOUTHEAST CORNER OF SECTION 24, T8S, R18W.

C. Description of monument for corner and accessories established to perpetuate locating the position of the corner:

SET 4" X 36" CONCRETE MONUMENT WITH BRASS CAP 18" BELOW THE SURFACE. THIS POSITION NOT ESTABLISHED BY ORIGINAL GOVERNMENT SURVEYORS. THIS MONUMENT IS ACCEPTED AS THE BEST AVAILABLE EVIDENCE OF THE POSITION OF THE CORNER.  
P.K. NAIL IN 48" OAK S 82 DEGREES 10' 38" W 308.24'  
P.K. NAIL IN 12" CHERRY S 86 DEGREES 53' 45" W 295.81'  
FOUND STONE 2' EAST CONC. MARKER FOR NW CORNER SEC 7, T38N, R2E IND. S89 DEGREES 48' 40" W 548.03'  
FOUND 5/8" IP IN MON. BOX IN C/L ROAD N 89 DEGREES 48' 27" E 2169.37'

	A	B	C	D	E	F	G	H	I	J	K	L	M
1													
2	6		5		4		3		2		1		
3													
4	7		8		9		10		11		12		
5													
6	18		17		16		15		14		13		
7													
8	19		20		21		22		23		24		
9													
10	30		29		28		27		26		25		
11													
12	31		32		33		34		35		36		
13													

Signed by *[Signature]*  
Surveyor's Michigan License No. 38117

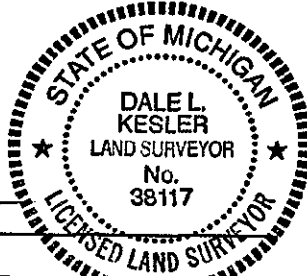

Date 11/2/99

APPROVED BY MICHIGAN STATE BOARD OF PROFESSIONAL SURVEYORS, JAN. 28, 1971  
REVISED MAY 14, 1976  
REVISED JAN., 1983  
REVISED OCT., 1995

DEC 23 1999

SECTION