REMONUMENTATION

JAN 31 2001


SURVEY &

LIBER 4

PAGE 250

REVISED OCT, 1999

SECTION

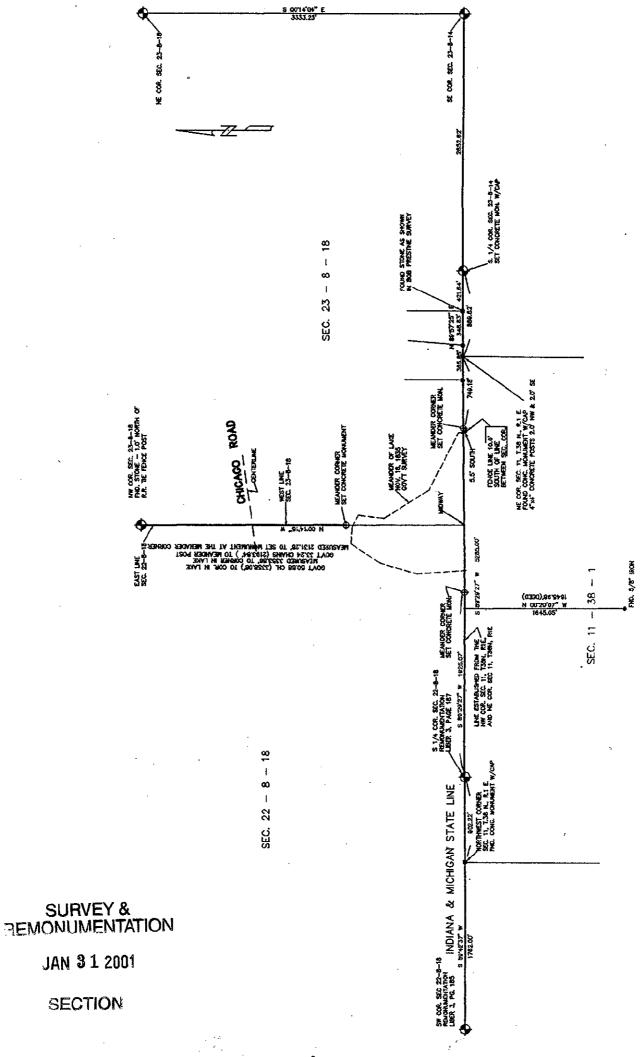

LIBER 4

PAGE 251