SECTION

JAN 31 2001

SURVEY & REMONUMENTATION

Surveyor's Michigan License No.


LIBER 4

A LANDSO.
NO.
38717
SOLAND SURVINGO.

PAGE 248

mi approved by "Richigan State Board of Professional Surveyors, Jan. 28, 187 i

ISIONAL SURVEYURS, JAHR. A., REVISED MAY 14.1975 REVISED JAN., 1983 REVISED OCT., 1995

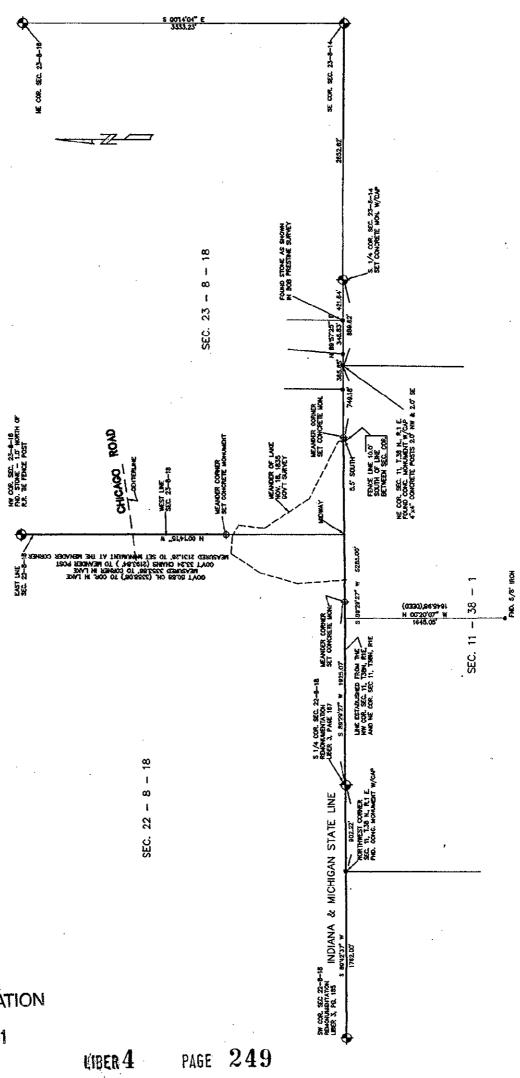

SURVEY & REMONUMENTATION

JAN 31 2001

SECTION