

SURVEY &
REMONUMENTATION

FEB 08 1999

SECTION

BRANCH COUNTY REMONUMATION PROGRAM
LAND CORNER RECORDATION CERTIFICATE
Filing Requirement of Act 74, Mich. P.A. 1970

For corners in

BRANCH COUNTY
BUTLER TWP

Located In:

Corner Code #

1. Public Land Survey

T 5 S R 5 W

C-5

T R

T R

T R

2. Property Controlling
in Section

S T R

S

T R

3. Miscellaneous

S

T R

Property in Sec.

S

T R

STATE OF MICHIGAN
Branch County
Recorded

11-04-1998 15:46:02

Linda Lee Morrison-Mathews
REGISTER OF DEEDS

Register of Deeds Stamp & File Number

ACCEPTED BY THE BRANCH COUNTY
SURVEY PEER GROUP AS THE OFFICIAL
CORNER UNDER MICHIGAN PUBLIC ACT 345
OF 1990 AT A MEETING HELD ON
9-09-1998

E.R. Reed Co. Rep.

E.R. REED

4. Lot No. , Recorded Plat

5. Private Claims

I, EDWARD W. REED, in a field survey on MAY 6, 19 98 do hereby state that under requirements of P.A. 74, Michigan P.A. of 1970, the corner points mentioned in lines 1 and 2 above were in conformance with regulations and rules therefore as required in the current manual of survey instructions of the United States Department of the Interior, Bureau of Land Management or by a decree of a Court of Law and /or that the corner points mentioned in lines 3, 4 and 5 above were in conformance with the rules of the Michigan Board of Land Surveyors or by a Decree of a Court of Law; established, re-established, monumented, recovered, found as expressed below:

NOTE: Not more than 2 corners, all in the same town and range, may be recorded on this certificate.

CORNER COMMON TO SECTIONS 7-8-17-18

A. Description of original monument and accessories and/or subsequent restoration:

1825: R. CLARK, JR. D.S. - CORNER SET

1878: M. KNOWLES, CO. SURVEYOR - FOUND STONE

1972: E.R. REED, CO SURVEYOR - FOUND FLAT TOPPED GREY STONE WELL SET IN CLAY, RECORDED IN LCRC # 0029

B. Description of corner evidence found and/or method applied in restoring or reestablishing corner:

FOUND 5/8" IRON ROD FITTING WITNESS OF LCRC # 0029, NO STONE FOUND

C. Description of monument for corner and accessories established to perpetuate locating the position of the corner:

SET 1/2" X 18" REBAR IRON WITH REMON CAP IN CI-MONUMENT BOX FLUSH WITH PAVED ROAD SURFACE


SQ. CONC. ANCHOR POST	N 56 E	36.0 TO SW CORNER
12" DIA RD CONC ANCHOR POST	S 39 W	46.20 TO TOP CENTER
POWER POLE	N 42 E	49.0' TO FACE
12" WALNUT	S 31 W	49.0' TO CENTER
N. END CMP ROAD CULVERT	N 46 W	32.7'

AND IS ACCEPTED AS A CAREFUL AND FAITHFUL PERPETUATION
OF THE POSITION OF THE ORIGINAL CORNER.

Signed by

EDWARD W. REED

Surveyor's Michigan License No. 33985

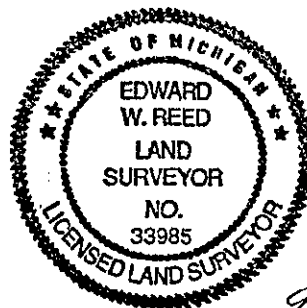

Date

9-9-98

Liber 000003 Page 0210