

CALHOUN COUNTY REMONUMENTATION  
LAND CORNER RECORDATION CERTIFICATE  
Filing Requirement of Act 74, Mich. P.A. 1970

APPROVED  
Date 8/16/95 LDJ  
CALHOUN COUNTY  
REMONUMENTATION.

For corners in

Calhoun

(County)

Located In:

Corner Code ##

1. Public Land Survey T 2 S R 4 W J-11  
T \_\_\_\_\_ R \_\_\_\_\_  
T \_\_\_\_\_ R \_\_\_\_\_  
T \_\_\_\_\_ R \_\_\_\_\_  
2. Property Controlling S \_\_\_\_\_ T \_\_\_\_\_ R \_\_\_\_\_  
in Section S \_\_\_\_\_ T \_\_\_\_\_ R \_\_\_\_\_  
3. Miscellaneous S \_\_\_\_\_ T \_\_\_\_\_ R \_\_\_\_\_  
Property in Sec. S \_\_\_\_\_ T \_\_\_\_\_ R \_\_\_\_\_

STATE OF MICHIGAN  
CALHOUN COUNTY  
RECORDED

30 AUG 95 11:28 A.M.

ANNE B. NORLANDER  
CLERK - REGISTER OF DEEDS  
Register of Deeds Stamp & File Number

4. Lot No. \_\_\_\_\_, Recorded Plat \_\_\_\_\_  
5. Private Claims \_\_\_\_\_

Donald J. Davis, in a field survey on August 10, 1995,  
do hereby certify that under requirements of P.A. 74, Michigan P.A. of 1970, the corner points mentioned  
in lines 1 and 2 above were in conformance with regulations and rules therefore as required in the  
current manual of survey instructions of the United States Department of the Interior, Bureau of Land  
Management or by a decree of a Court of Law and/or that the corner points mentioned in lines 3, 4 and 5  
above were in conformance with the rules of the Michigan Board of Land Surveyors or by a Decree of a  
Court of Law; established, re-established, monumented, re-monumented, recovered, found as  
expressed below:

**NOTE: Not more than 4 corners, all in the same town and range, may be recorded  
on this certificate.**

6. Description of original monument and accessories and/or subsequent restoration:

Original survey in 1925 by Lyon.

19" B. Oak N 77° E 59 links, 18" White Oak N 39° W, 52 links.

5/8" square rod with rocks set in 1938 by R.L. Barry, RLS #2258.

15" Maple S 71° E, 27.55'.

SW corner house N 39° E, 112.40'.

13" Maple S 19° E, 75.40'.

7. Description of corner evidence found and/or method applied in restoring or reestablishing corner:

Found 5/8" square rod 12" long with rocks around under bituminous surface. Fit good  
to SW corner house witness.

Accepted as good location of corner perpetuation.

	A	B	C	D	E	F	G	H	I	J	K	L	M
2	6		5		4		3		2		1		
3													
4	7		8		9		10		11		12		
5													
6	18		17		16		15		14		13		
7													
8	19		20		21		22		23		24		
9													
10	30		29		28		27		26		25		
11													
12	31		32		33		34		35		36		
13													

CERTIFICATE  
REMONUMENTATION

LIBER 1818 PAGE 320

FEB 22 1996

COMMISSION

8. Description of monument for corner and accessories established to perpetuate locating the position of the corner:

Set Berntsen brass monument with rocks around in monument box.


Nail & Tag 48" Maple S 85° W, 27.33'.

Nail & Tag Utility Pole S 40° E, 32.19'.

Top nut fire hydrant N 70° E, 24.78'.

SE corner house foundation N 65° W, 73.35'.

SW corner house foundation N 39° E, 112.40'.

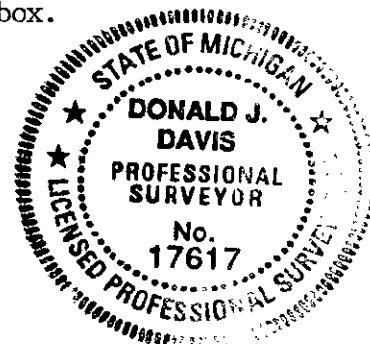

Signed by Donald J. Davis

Date August 11, 1995

Surveyor's Michigan License No. 17617