

APPROVED

MAR 30 1999

Date 12-9-98 RRC

CALHOUN COUNTY
REMONUMENTATION

CALHOUN COUNTY REMONUMENTATION
LAND CORNER RECORDATION CERTIFICATE
Filing Requirement of Act 74, Mich. P.A. 1970

STATE OF MICHIGAN
CALHOUN COUNTY
RECORDED

15 DEC 1998 3:37:40 PM

ANNE D. NORLANDER
CLERK - REGISTER OF DEEDS

LIBER 2087 PAGE 936

Register of Deeds Stamp & File Number

For corners in

CALHOUN (County)	Located In:	Corner Code #
MARSHALL		
1. Public Land Survey	T 2S R 6W	L-3
	T R	
	T R	
	T R	
2. Property Controlling in Section	S T R	
	S T R	
3. Miscellaneous Property in Sec.	S T R	
	S T R	

4. Lot No. , Recorded Plat
5. Private Claims

I, Michael A. Groat, in a field survey on November, 1998 do hereby state that under requirements of P.A. 74, Michigan P.A. of 1970, the corner points mentioned in lines 1 and 2 above were in conformance with regulations and rules therefore as required in the current manual of survey instructions of the United States Department of the Interior, Bureau of Land Management or by a decree of a Court of Law and for that the corner points mentioned in lines 3, 4 and 5 above were in conformance with the rules of the Michigan Board of Land Surveyors or by a Decree of a Court of Law; established, re-established, monumented, recovered, found as expressed below:

NOTE: Not more than 2 corners, all in the same town and range, may be recorded on this certificate.

A. Description of original monument and accessories and/or subsequent restoration:

ORIGINAL SURVEY BY LUCIUS LYON, 1825, SET POST 40.10 CH EAST OF SW CORNER OF SECTION, W. OAK 10", N 79 3/4° E, 14.85 LKS, W. OAK, 13" S 51° E, 5.54 LKS.

JAMES GIFFORD, 1891, FOUND CORNER AT INTERSECTION OF FENCES, WILLOW, 9", N 35° W, 248 LKS.
NO OTHER TREE NEAR.


B. Description of corner evidence found and/or method applied in restoring or reestablishing corner:

FOUND TILE ON WESTERLY EXTENSION OF FENCE. THE TILE IS ON THE SOUTHERLY BANK OF A CREEK/DITCH. EXCAVATED AND FOUND ROCKS AROUND THE TILE. ACCEPTED THE TILE AS A FAITHFUL PERPETUATION OF THE ORIGINAL MONUMENT.

C. Description of monument for corner and accessories established to perpetuate locating the position of the corner:

SET A BERNTSEN MONUMENT IN PLACE OF THE TILE.

NAIL & TAG 5" ASH, S 5° E, 12.85'
NAIL & TAG 7" ASH, S 75° W, 33.2'
NAIL & TAG 24" TWIN ASH, EAST, 21.05'
NAIL & TAG 6" CHERRY, SOUTH, 3.9'
NAIL & TAG 6" CHERRY, WEST, 6.0'
NAIL & TAG 18" OAK, EAST, 43.4'

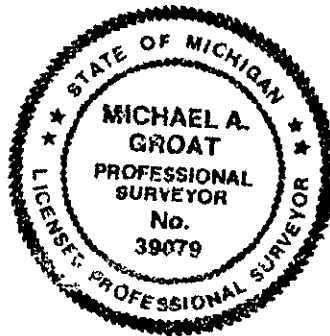

Signed by [Signature]

Date December 4, 1998

Surveyor's Michigan License No. 39079