

SURVEY & REMONUMENTATION

1993

RECORDED

COMMISSION

CALHOUN COUNTY REMONUMENTATION LAND CORNER RECORDATION CERTIFICATE Filing Requirement of Act 74, Mich. P.A. 1970

Nov 18 2 22 PM '93

CLERK-REGISTER
CALHOUN COUNTY, MICH.
ANNE B. NORLANDER

For corners in

Calhoun

(County)

Located In:

Corner Code --

Battle Creek Township

1. Public Land Survey

T 2S R 8W

I-12

T R

T R

T R

2. Property Controlling
in Section

S T R

S T R

3. Miscellaneous
Property in Sec.

S T R

S T R

Register of Deeds Stamp & File Number

4. Lot No. , Recorded Plat

5. Private Claims

I, Michael A. Groat, in a field survey on November 16, 19 93, do hereby certify that under requirements of P.A. 74, Michigan P.A. of 1970, the corner points mentioned in lines 1 and 2 above were in conformance with regulations and rules therefore as required in the current manual of survey instructions of the United States Department of the Interior, Bureau of Land Management or by a decree of a Court of Law and/or that the corner points mentioned in lines 3, 4 and 5 above were in conformance with the rules of the Michigan Board of Land Surveyors or by a Decree of a Court of Law; established, re-established, monumented, re-monumented, recovered, found as expressed below:

NOTE: Not more than 4 corners, all in the same town and range, may be recorded on this certificate.

A. Description of original monument and accessories and/or subsequent restoration:

Resurvey:

Tile

16" Red Oak, S82½°E, 69 links

12" Hickory, S86½°W, 49½ links

1959

3" Iron Stake

36" Oak, SW, 50.92 feet

36" Oak, NW, 53.8 feet

U.P. NE 78.56 feet

1978

Re-rod in pipe over tile

12'± South fence East

6'±, West centerline

14" Apple, N55°W, 32.62 feet

12" Maple, S40°W, 28.63 feet

22" Oak, S45°E, 47.45 feet

B. Description of corner evidence found and/or method applied in restoring or reestablishing corner:

Found P.K. nail set by Davis from DeKeyser surveys as a perpetuation of the corner.

Removed P.K. and excavated a 3'x6'x3' deep area in search of tile and pipe.

	A	B	C	D	E	F	G	H	I	J	K	L	M
2	6		5		4		3		2		1		
3													
4	7		8		9		10		11		12		
5													
6	13		17		16		15		14		13		
7													
8	19		20		21		22		23		24		
9													
10	30		29		28		27		26		25		
11													
12	31		32		33		34		35		36		
13													

C. Description of monument for corner and accessories established to perpetuate locating the position of the corner:


Set Bernstein monument in Mon box. Stamped 39079 & set drill hole.

18" Twin Maple, S25°W, 30.4 feet. Set nail & spotter.

20" Oak, S25°E, 50.3 feet

20" Oak, N10°E, 77.50 feet

NW corner fence post, N80°E, 36.30 feet

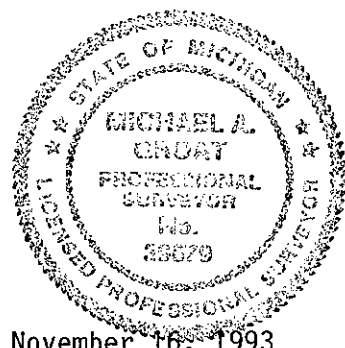

Signed by

Michael A. Groat

Date

November 16, 1993

Surveyor's Michigan License No.

39079