

SURVEY &
REMONUMENTATION

APPROVED

Date 2-2-94

CALHOUN COUNTY
REMONUMENTATION.

For corners in

This document is being re-recorded to correct Town designation.

APR 26 1995

CALHOUN COUNTY REMONUMENTATION
LAND CORNER RECORDATION CERTIFICATE
Filing Requirement of Act 74, Mich. P.A. 1970

COMMISSION

Calhoun
(County)

Located In:

Corner Code #

1. Public Land Survey

T R

"Other" Code

2. Property Controlling
in Section

S T R

#1

3. Miscellaneous
Property in Sec.

S 27 T 3 S. R 7 W.

#2

4. Lot No. , Recorded Plat

5. Private Claims

STATE OF MICHIGAN
CALHOUN COUNTY
RECORDED

13 DEC 94 3:49 P.M.

ANNE D. NORLANDER
Register of Deeds Stamp Clerk

I, Michael A. Groat, in a field survey on January, 19 94, do hereby certify that under requirements of P.A. 74, Michigan P.A. of 1970, the corner points mentioned in lines 1 and 2 above were in conformance with regulations and rules therefore as required in the current manual of survey instructions of the United States Department of the Interior, Bureau of Land Management or by a decree of a Court of Law and/or that the corner points mentioned in lines 3, 4 and 5 above were in conformance with the rules of the Michigan Board of Land Surveyors or by a Decree of a Court of Law; established, re-established, monumented, re-monumented, recovered, found as expressed below:

NOTE: Not more than 4 corners, all in the same town and range, may be recorded on this certificate.

A. Description of original monument and accessories and/or subsequent restoration:

Original Survey:

Sibley 1826

Set meander post on North and South side of Lee Lake

Post on South side:

3 chains North of SW corner

set post, from which:

7" White oak, East, 85 links

26" White oak, S27°W, 78 links

Post on North side:

56.65 chains North of SW corner

set post from which

6" Black Oak, S69°W 4 links

6" Black Oak, N7°W 9 links

No record of
anything set or
found in re-survey

B. Description of corner evidence found and/or method applied in restoring or reestablishing corner:

Found no evidence of meander corners. Traversed between G-9 and G-11 and set new meander corners.

CLERK - REGISTER OF DEEDS
ANNE D. NORLANDER

20 DEC 94 1:54 P.M.

RECORDED
CALHOUN COUNTY
STATE OF MICHIGAN

#1 LIBER 1780 PAGE 627

#2 LIBER 1781 PAGE 675

C. Description of monument for corner and accessories established to perpetuate locating the position of the corner:

Set Berntsen monuments 231' North of G-11 and 1629.4' South of G-9 on Section line.

Witnesses: South shore

Nail and spotter in 6" Cherry, N50°E, 1.7'

Nail and spotter in 14" Oak, S70°W, 32.7'

Nail and spotter in 6" Oak, S10°E, 16.6'

231' North of Southwest corner of Sec. 27


North shore

Nail and spotter in 12" Mulberry, North, 61.8'

Nail and spotter in 4" Willow, S86°E, 61.2'

Nail and spotter in 10" Birch, S84°W, 99.5'

Nail and spotter in 5" Birch, S55°W, 91.4'

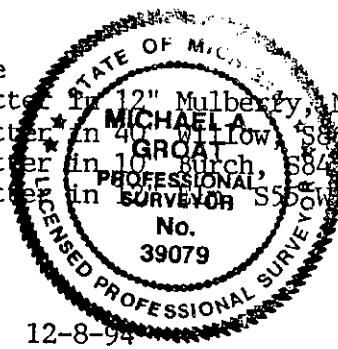

Signed by Michael A. Groat

Date 12-8-94

Surveyor's Michigan License No. 39079