

APPROVED  
Date 11/17/99 ERC  
CALHOUN COUNTY  
REMONUMENTATION

CALHOUN COUNTY REMONUMENTATION  
LAND CORNER RECORDATION CERTIFICATE  
Filing Requirement of Act 74, Mich. P.A. 1970

STATE OF MICHIGAN  
CALHOUN COUNTY  
RECORDED

17 DEC 1999 2:45:41 PM

ANNE B. NORLANDER  
CLERK - REGISTER OF DEEDS

LINER **2186** PAGE **4**

Register of Deeds Stamp & File Number

For corners in  
CALHOUN Located in: Corner Code #  
(County)  
CLARENDON TWP.

1. Public Land Survey T4S R5 W J-9  
T R  
T R  
T R  
2. Property Controlling S T R  
in Section S T R  
3. Miscellaneous S T R  
Property in Sec. S T R

4. Lot No. , Recorded Plat  
5. Private Claims

I, Frederick J. Cutcher, in a field survey on August 16, 1999 do hereby state that under requirements of P.A. 74, Michigan P.A. of 1970, the corner points mentioned in lines 1 and 2 above were in conformance with regulations and rules therefore as required in the current manual of survey instructions of the United States Department of the Interior, Bureau of Land Management or by a decree of a Court of Law and for that the corner points mentioned in lines 3, 4 and 5 above were in conformance with the rules of the Michigan Board of Land Surveyors or by a Decree of a Court of Law, established, re-established, monumented, recovered, found as expressed below:

	A	B	C	D	E	F	G	H	I	J	K	L	M
1													
2		6		5		4		3		2		1	
3													
4		7		8		9		10		11		12	
5													
6		18		17		16		15		14		13	
7													
8		19		20		21		22		23		24	
9													
10		30		29		28		27		26		25	
11													
12		31		32		33		34		35		36	
13													

NOTE: Not more than 2 corners, all in the same town and range, may be recorded on this certificate.

A. Description of original monument and accessories and/or subsequent restoration:

GLO, Robert Clark, Jr., 1825: W. Oak 17" N. 35° E. 10 1/2 lks.; W. Oak 18" S. 12° W. 23 1/2 lks.  
Witness Card, 1927, Gunn: Iron rod, 6" pine in cemetery S. 28° W. 105.8'; 4" Peach S. 60° W. 67.0'; N.E. cor. base of John & Mary Camburn's tombstone S. 44° W. 67.2'; N.E. cor. post of cemetery S. 41° W. 46.1'.  
Monument Box set by road commission sometime around 1980.  
Witness Card, 8/10/82, Cutcher: Found iron pipe in monument box.


B. Description of corner evidence found and/or method applied in restoring or reestablishing corner:

Found 1" diameter iron pipe surrounded with stones in monument box (also found some type of iron pipe 0.4± E.S.E.).  
Three of Gunn's witnesses remain.

C. Description of monument for corner and accessories established to perpetuate locating the position of the corner:

Set Berntsen Monument in Monument Box over iron pipe found and is accepted as the best available evidence of the position of the original corner.  
1.5' N. of centerline T Drive S.; 6± E. of centerline 22 1/4 Mile Road.  
N.E. corner R.R. track corner post S. 45° W. 46.35'; top cen. tel. stan. North 27.83'; Nail & spotter 12" Maple N. 52° W. 44.88'; N.E. corner R.R. track gate post S. 75° W. 108.85'.

Signed by Frederick J. Cutcher  
Surveyor's Michigan License No. 24592

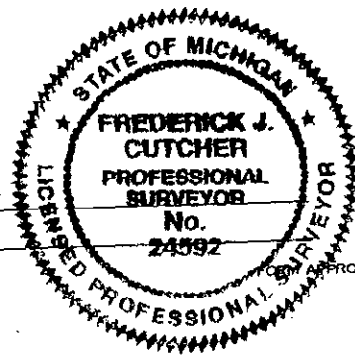

Date 11/15/99

SURVEY &  
REMONUMENTATION

MAR 13 2000

SECTION

APPROVED BY MICHIGAN STATE BOARD OF PROFESSIONAL SURVEYORS, JAN. 28, 197  
REVISED MAY 14, 1975  
REVISED JAN., 198  
REVISED OCT., 199