

APPROVED

Date 10-29-98 RRL

CALHOUN COUNTY
REMONUMENTATION.

CALHOUN COUNTY REMONUMENTATION
LAND CORNER RECORDATION CERTIFICATE
Filing Requirement of Act 74, Mich. P.A. 1970

STATE OF MICHIGAN
CALHOUN COUNTY
RECORDED

29 OCT 1998 2:41:02 PM

AND R. NORRIS
CLERK - REGISTER OF DEEDS

LIBER 2073 PAGE 284

Register of Deeds Stamp & File Number

For corners in

| Calhoun | Located in: | Corner Code # |
|-------------------------|-------------|---------------|
| (County) | | |
| Burlington Township | | |
| 1. Public Land Survey | T 4 S R 7 W | D-3 |
| | T R | |
| | T R | |
| | T R | |
| 2. Property Controlling | S T R | |
| in Section | S T R | |
| 3. Miscellaneous | S T R | |
| Property in Sec. | S T R | |

4. Lot No. , Recorded Plat
5. Private Claims

I, William K. Crane, in a field survey on October 17, 1998, do hereby state that under requirements of P.A. 74, Michigan P.A. of 1970, the corner points mentioned in lines 1 and 2 above were in conformance with regulations and rules therefore as required in the current manual of survey instructions of the United States Department of the Interior, Bureau of Land Management or by a decree of a Court of Law and/or that the corner points mentioned in lines 3, 4 and 5 above were in conformance with the rules of the Michigan Board of Land Surveyors or by a Decree of a Court of Law; established, re-established, monumented, recovered, found as expressed below:

NOTE: Not more than 2 corners, all in the same town and range, may be recorded on this certificate.

| | A | B | C | D | E | F | G | H | I | J | K | L |
|----|----|---|---|----|---|----|---|----|---|----|---|----|
| 1 | | | | | | | | | | | | |
| 2 | 6 | | | 5 | | 4 | | 3 | | 2 | | 1 |
| 3 | | | | | | | | | | | | |
| 4 | 7 | | | 8 | | 9 | | 10 | | 11 | | 12 |
| 5 | | | | | | | | | | | | |
| 6 | 18 | | | 17 | | 16 | | 15 | | 14 | | 13 |
| 7 | | | | | | | | | | | | |
| 8 | 19 | | | 20 | | 21 | | 22 | | 23 | | 24 |
| 9 | | | | | | | | | | | | |
| 10 | 30 | | | 29 | | 28 | | 27 | | 26 | | 25 |
| 11 | | | | | | | | | | | | |
| 12 | 31 | | | 32 | | 33 | | 34 | | 35 | | 36 |
| 13 | | | | | | | | | | | | |

A. Description of original monument and accessories and/or subsequent restoration:

G.L.O. Robert Clark, 1826:

13" W. Oak S 85-1/2 E 1262 links
12" W. Oak N 7-1/2 E 348 links

H. K. Whitney, 1904:

4' E. of center of ditch & 20" S. of center of crossway
9" Willow S 13° 50' W 31' 10"
7" Willow S 48-1/2 W 31' 4"

Cart. 7/92:

Found 1/2" iron (set by Davis)
In center of E&W road
12" Elm S 50° W 104.02'
240' East of centerline of drainage ditch

Ryan, 12/92:

Found 1/2" iron
Fence corner post S 5° W 48.07'
12" Elm S 60° W 104.07'
On centerline of E&W road


B. Description of corner evidence found and/or method applied in restoring or reestablishing corner:

Found 1/2" rered as referenced above. Replaced with Berntsen monument and monument box.

C. Description of monument for corner and accessories established to perpetuate locating the position of the corner:

Set standard Calhoun County Remonumentation monument (Berntsen monument) with monument box and is accepted as the best available evidence of the position of the original corner.

| | | |
|--|-----------------|----------|
| NE Section Corner | S 88° 03' 15" W | 2684.54' |
| NW Section Corner | N 88° 03' 23" E | 2684.46' |
| 8" Birch | S 10° W | 43.25' |
| Centerline ditch | East | 240' |
| 0.5' North of centerline bituminous road | | |

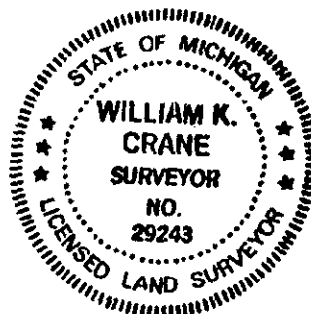

SURVEY &
REMONUMENTATION

MAR 30 1999

SECTION

Signed by William K. Crane

William K. Crane, P.S.

Surveyor's Michigan License No. 29243

Date 10/23/98