

Ratified by Peer Group

In Accordance With P.A. 345

Chairman Dale Kesler

Date December 20, 1995

For corners in

CASS

(County)

Located In:

Corner Code #

LAND CORNER RECORDATION CERTIFICATE

Filing Requirement of Act 74, Mich. P.A. 1970

CASS COUNTY REMONUMENTATION

STATE OF MICHIGAN
COUNTY OF CASS
Recorded

12-28-1995 08:07:55

Ann L. Simmons
REGISTER OF DEEDS

Register of Deeds Stamp & File Number

- | | | | |
|-------------------------|------------|-------------|-------------|
| 1. Public Land Survey | T <u>5</u> | R <u>16</u> | <u>A-13</u> |
| SILVER CREEK TWP. | T | R | |
| | T | R | |
| | T | R | |
| | T | R | |
| 2. Property Controlling | S | T | R |
| in Section | S | T | R |
| 3. Miscellaneous | S | T | R |
| Property in Sec. | S | T | R |

4. Lot No. _____, Recorded Plat _____
5. Private Claims _____

I, DALE L. KESLER, in a field survey on November 2, 19 94
do hereby certify that under requirements of P.A. 74, Michigan P.A. of 1970, the corner points mentioned
in lines 1 and 2 above were in conformance with regulations and rules therefore as required in the
current manual of survey instructions of the United States Department of the Interior, Bureau of Land
Management or by a decree of a Court of Law and/or that the corner points mentioned in lines 3, 4 and 5
above were in conformance with the rules of the Michigan Board of Land Surveyors or by a Decree of a
Court of Law, established, re-established, monumented, re-monumented, recovered, found as
expressed below:

NOTE: Not more than 4 corners, all in the same town and range, may be recorded
on this certificate.

A. Description of original monument and accessories and/or subsequent restoration:

1827 - William Brookfield - Set post, accessories - 26" White Oak N. 24° E. 57 Lks.,
15" White Oak S. 24° W. 62 Lks.: 1931 - Dewey found stone, no witnesses; 1971 -
Dreher Surveying found railroad spike - Set 1/2" bar, accessories - center of phone
pole N. 45° W. 38 feet, center of Utility pole in yard N. 30° E. 88.3', center of
14" Sycamore S. 5° E. 136.6 feet; 1978 - Doug Peirce found 1/2" pin in box, set
standard monument in existing box, L.C.R.C. Liber 2, Page 210, accessories - Power
pole N. 45° W. 38.10 feet, 14" Oak S. 14° E. 136.70 feet.

B. Description of corner evidence found and/or method applied in restoring or reestablishing corner:

Found standard aluminum monument in monument box. Accepted monument as best
evidence of corner.


MAR 27 1996

COMMISSION

C. Description of monument for corner and accessories established to perpetuate locating the position of the corner:

Set standard 3' long pipe with brass plate in place of the standard aluminum
monument and is accepted as a careful and faithful perpetuation of the original
corner.

Set nail w/witness tag in 14" Twin Poplar S. 80° E. 17.89'
Set nail w/witness tag 8" Poplar N. 50° E. 23.45'
Found MDSH tag in power pole N. 40° E. 38.15'
Centerline top of phone riser N. 40° E. 47.59'

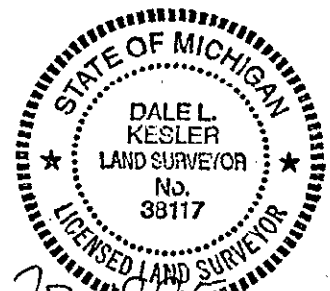

Signed by Dale L. Kesler
Surveyor's Michigan License No. No. 38117

Date December 27, 1995