

Attested by Peer Group  
Accordances With P.A. 345  
Chairman Dale L. Kesler  
Date December 20, 1995

LAND CORNER RECORDATION CERTIFICATE  
Filing Requirement of Act 74, Mich. P.A. 1970

STATE OF MICHIGAN  
COUNTY OF CASS  
Recorded

12-28-1995 16:08:46

Ann L. Simmons  
REGISTER OF DEEDS

or corners in  
CASS (County)  
Located In: CASS COUNTY REMONUMENTATION  
Corner Code #

Public Land Survey	T	7	R	13	M-5
NORTH PORTER TWP.	T		R		
	T		R		
	T		R		
	T		R		
Property Controlling	S		T	R	
in Section	S		T	R	
Miscellaneous	S		T	R	
Property in Sec.	S		T	R	

Register of Deeds Stamp & File Number

Lot No. , Recorded Plat  
Private Claims

DALE L. KESLER, in a field survey on NOVEMBER 28, 19 95  
I hereby certify that under requirements of P.A. 74, Michigan P.A. of 1970, the corner points mentioned in lines 1 and 2 above were in conformance with regulations and rules therefore as required in the current manual of survey instructions of the United States Department of the Interior, Bureau of Land Management or by a decree of a Court of Law and/or that the corner points mentioned in lines 3, 4 and 5 above were in conformance with the rules of the Michigan Board of Land Surveyors or by a Decree of a Court of Law; established, re-established, monumented, re-monumented, recovered, found as expressed below:

	A	B	C	D	E	F	G	H	I	J	K	L	M
2	6	5	4	3	2	1							
3													
4	7	8	9	10	11	12							
5													
6	18	17	16	15	14	13							
7													
8	19	20	21	22	23	24							
9													
10	30	29	28	27	26	25							
11													
12	31	32	33	34	35	36							
13													

NOTE: Not more than 4 corners, all in the same town and range, may be recorded on this certificate.

A. Description of original monument and accessories and/or subsequent restoration:

Dec. 26, 1826 - William Brookfield - Set post by going North on the East line Sec. 13 from East Quarter post 40.00 chains (2640.00')  
10" White Oak tree - S. 12 3/4° W. - 48 links (31.68')  
15" White Oak tree - N. 9° W. - 47 links (31.02')

Aug. 6, 1886 - Amos Smith, County Surveyor - Found Witnesses and reset with Burr Oak post- 15" White Oak - N. 40 1/2° W. 59 1/4 Links (39.11')

(Over)

B. Description of corner evidence found and/or method applied in restoring or reestablishing corner:

Found concrete monument with aluminum cap. The accessories of the 1989 survey by Donald Bissell verify location of corner. Distance to adjacent corners were reasonable and consistent. Accepted concrete monument as best evidence of corner.


MAR 27 1996

COMMISSION

C. Description of monument for corner and accessories established to perpetuate locating the position of the corner:

Found concrete monument with aluminum cap and is accepted as a careful and faithful perpetuation of the original corner.

- Blaze in 6" Hickory tree - N. 29 Deg. E. 27.30'
- Blaze in 4" Hickory - S. 17 Deg. E. 21.06'
- Blaze in 6" White Oak - N. 69 Deg. W. 31.63'
- Blaze in 20" Red Oak - N. 36 Deg. W. 20.60'
- 4" Conc. Mon. - S. 4 Deg. W. 76.50'

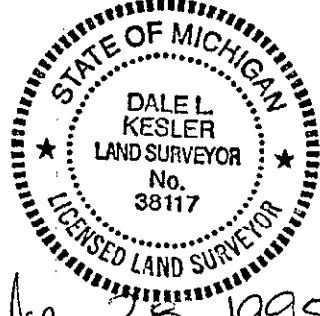

Signed by Dale L. Kesler Date December 28, 1995  
Surveyor's Michigan License No. No. 38117

A. Continued

Dec. 3, 1889 - F. E. Smith, County Surveyor - Identified Government Witness, also the Witness marked by A. Smith - Surveyed NW 1/4, NE 1/4 and SE 1/4, Section 12, Measured from E 1/4 corner to SE Cor. 39.92 Links (2634.72')  
10" Yellow Oak - S. 54 3/4° W. 74 Links (36.14')  
15" White Oak tree - N. 48 1/2° W. 59 1/4 Links (39.11')

Oct. 1989 - Donald Bissell - Set 4" X 36" Concrete monument with aluminum cap in place of rotted stake in old N/S fenceline - Recorded January 30, 1990, Liber 2, Pg. 323  
Blaze in 6" 6" Hickory - N. 29 Deg. E. 27.30'  
Blaze in 4" Hickory - S. 17 Deg. E. 21.06'  
Blaze in 6" White Oak - N. 69 Deg. W. 31.63'  
Blaze in 4" Red Oak - N. 36 Deg. W. 20.60'  
4" Concrete monument - S. 4 Deg. W. 76.50'