

SURVEY & REMONUMENTATION

FEB 19 1998

Liber 000003 Page 0125

SECTION

LAND CORNER RECORDATION CERTIFICATE  
Filing Requirement of Act 74, Mich. P.A. 1970  
CASS COUNTY REMONUMENTATION

For corners in

CASS

(County)

Located In:

Corner Code #

1. Public Land Survey  
JEFFERSON TWP.

T 7S R 15W

I-1

2. Property Controlling  
in Section

3. Miscellaneous  
Property in Sec.

T R  
T R  
T R  
S T R  
S T R  
S T R  
S T R

STATE OF MICHIGAN  
COUNTY OF CASS  
Recorded

12-26-1997 11:55:19

Ann L. Simmons  
REGISTER OF DEEDS

Register of Deeds Stamp & File Number

Relayed by Peer Group  
In Accordance With P.A. 845  
Chairman Dale Kesler

4. Lot No. , Recorded Plat

5. Private Claims

I, DALE L. KESLER, in a field survey on AUG. 13, 1997 do hereby state that under requirements of P.A. 74, Michigan P.A. of 1970, the corner points mentioned in lines 1 and 2 above were in conformance with regulations and rules therefore as required in the current manual of survey instructions of the United States Department of the Interior, Bureau of Land Management or by a decree of a Court of Law and /or that the corner points mentioned in lines 3, 4 and 5 above were in conformance with the rules of the Michigan Board of Land Surveyors or by a Decree of a Court of Law; established, re-established, monumented, recovered, found as expressed below:

NOTE: Not more than 2 corners, all in the same town and range, may be recorded on this certificate.

A. Description of original monument and accessories and/or subsequent restoration:

\*1828 SURVEY BY WILLIAM BROOKFIELD. INT. NORTH BOUNDARY 398 LKS W. OF POST. WITNESSES: 14" OAK S 32 3/4 DEGREES W 15 LKS., 15" OAK S 26 DEGREES E 832 LKS.

B. Description of corner evidence found and/or method applied in restoring or reestablishing corner:

NO MONUMENT FOUND AT THIS CORNER. REESTABLISHED AT THE GOVERNMENT JOG OF 262.68 FEET WEST OF THE SE CORNER OF SECTION 34, T6S, R15W, AND ON LINE BETWEEN THE SE CORNER OF SECTION 34, T6S, R15W AND THE S 1/4 CORNER OF SAID SECTION 34, T6S, R15W.

C. Description of monument for corner and accessories established to perpetuate locating the position of the corner:

SET 3/4" IRON PIPE WITH ALUMINUM CAP IN A MONUMENT BOX AND IS ACCEPTED AS A CAREFUL AND FAITHFUL REESTABLISHMENT OF THE POSITION OF THE ORIGINAL CORNER.


PK NAIL IN POWER POLE N 50 DEGREES 25' E 140.97'

R.R. TIE POST N 32 DEGREES 14' E 60.64'

MULBERRY GROUP MOST NORTHERLY TREE 8" S 50 DEGREES E 62.30'

PK NAIL IN 8" OAK S 64 DEGREES 31' W 82.20'

SE COR. SECTION 34, T6S, R15W, EAST 262.68'

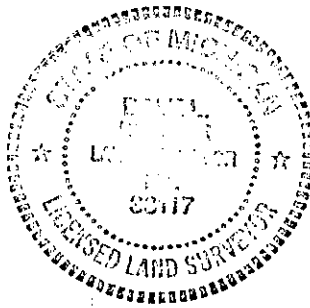

Signed by

Dale Kesler

Date 12/24/97

Surveyor's Michigan License No.

38117