



MAP SHEET

TOWN 42 N RANGE 6 E

COUNTY		TOWNSHIP	NUMBER OF ACRES	DATE	FILE NO.
Chippewa					
OWNER OF LAND				DIVISION	
				DISTRICT	
				MAPPED BY:	
PURPOSE OF MAP				PHOTO NUMBERS	

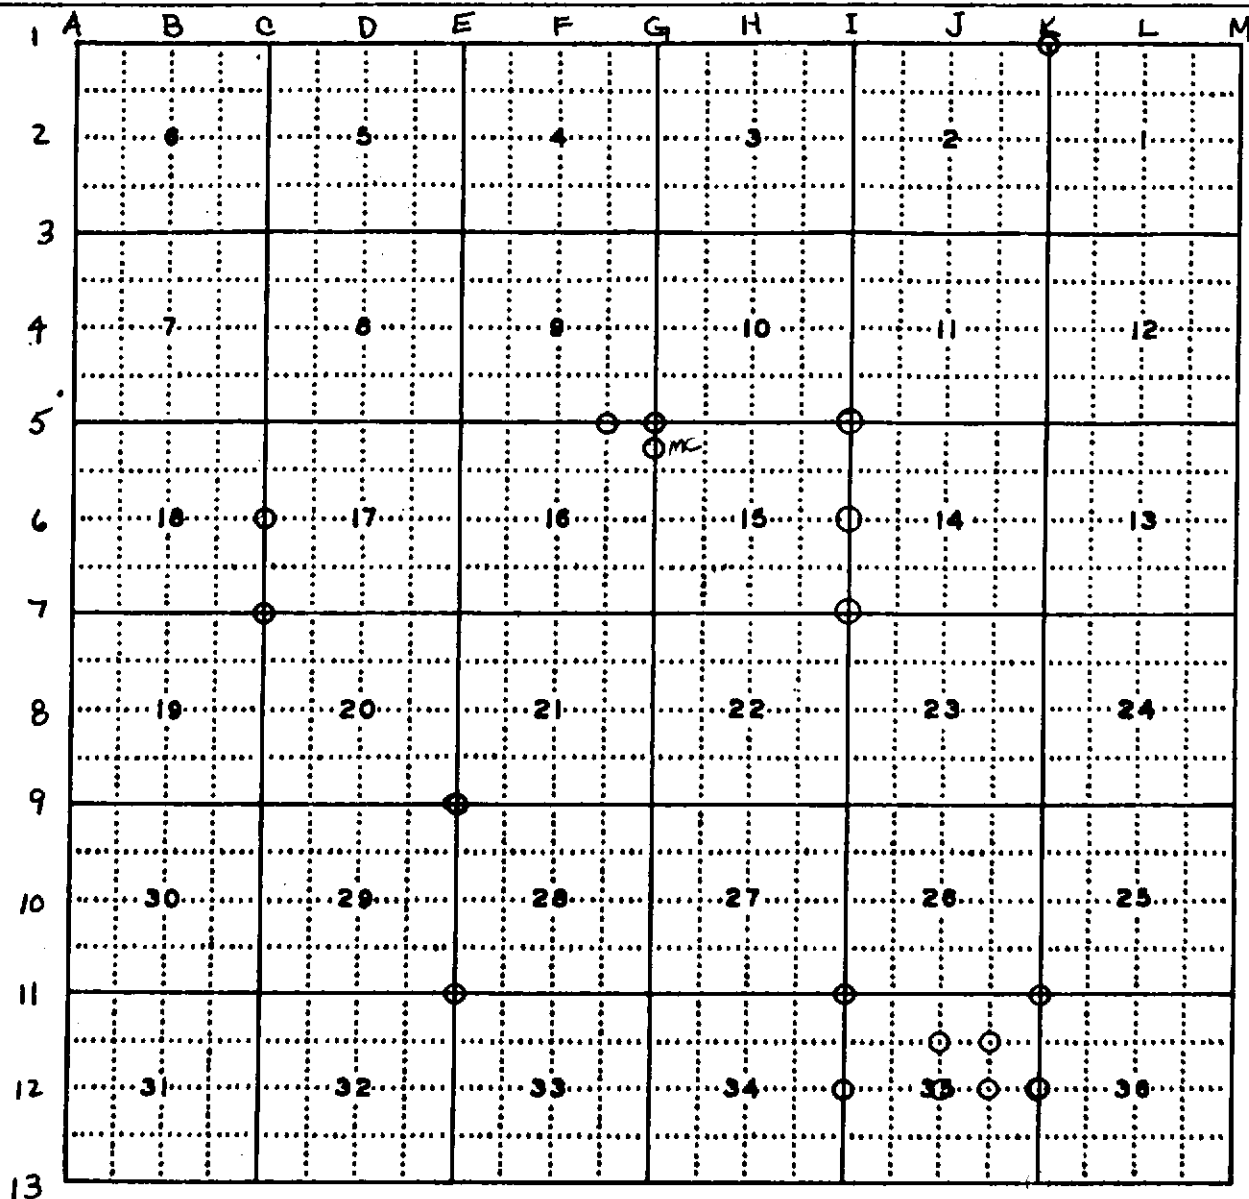

REMARKS

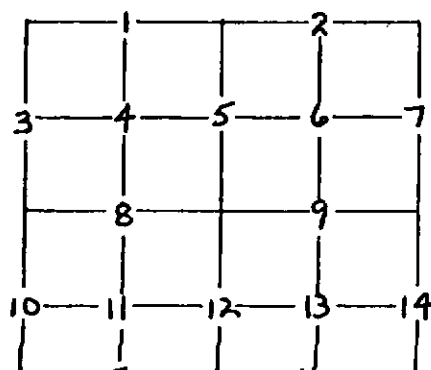

- denotes 2 records