

**SURVEY &
REMONUMENTATION**

CHIPPEWA COUNTY REMONUMENTATION CORNER

APR 26 1995

LAND CORNER RECORDATION CERTIFICATE

Filing Requirement of Act 74, Mich. P.A. 1970

For corner in
Chippewa
(County)

Located In:

Corner Code #

1. Public Land Survey

T 44N R 1W

A-1 Same

T 45N R 1W

A-13 Corner

T 44N R 2W

M-1 (Township

T 45N R 2W

M-13 Corner)

2. Property Controlling
in Section


S T R

3. Miscellaneous
Property in Sec.

S T R

4. Lot No. , Recorded Plat

5. Private Claims

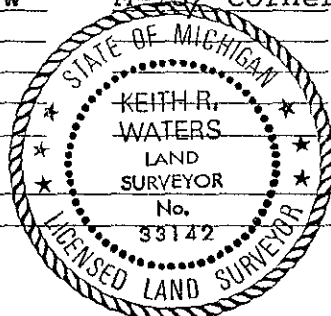

\$ 7.00 LAND CORNER

\$ 2.00 MSSR

5 DEC 94 12:36 P.M. RECEIPT# 1520

RECEIVED FOR RECORD

CHIPPEWA COUNTY - STATE OF MICHIGAN
SHARON H. KENNEDY, REGISTER OF DEEDS

Register of Deeds Stamp & File Number

I, Keith R. Waters, in a field survey on November 11, 19 94, do hereby certify that under requirements of P.A. 74, Michigan P.A. of 1970, the corner points mentioned in lines 1 and 2 above were in conformance with regulations and rules theretore as required in the current manual of survey instructions of the United States Department of the Interior, Bureau of Land Management or by a decree of a Court of Law and/or that the corner points mentioned in lines 3, 4 and 5 above were in conformance with the rules of the Michigan Board of Land Surveyors or by a Decree of a Court of Law; established, re-established, monumented, re-monumented, recovered, found as expressed below:

NOTE: Not more than 4 corners, all in the same town and range, may be recorded on this certificate.

A. Description of original monument and accessories and/or subsequent restoration:

A-13 (T45N, R1W) Corner Common to T44N,R1W, T45N,R1W, T44N,R2W & T45N,R2W.

Original ties to post: Cedar 12, N47°E 08 links - Pine 14, S75°W 17 links.
1978 - As recorded in liber 1, page 366, Chippewa County corner records, by Thomas M. Kelly, R.L.S. 24599. Found 2" pipe and decayed post matching County Surveyor notes dated October 1913. Witnesses: 12" White Birch, N80°E 18.69' 6" Pine, S66°W 19.13' 8" Pine, N40°W 33.88'

B. Description of corner evidence found and/or method applied in restoring or reestablishing corner:

A-13 (T45N, R1W)

This corner is being perpetuated as part of the Chippewa County Remonumentation Program.

Found a 2" iron pipe 3 feet above ground in a swampy area approximately 1200 feet west of a north-south 2-track road west of the Chippewa County International Airport. I located this pipe in a previous survey in 1987 and it checked well with other corners in area as shown on a sketch done by Thomas M. Kelly, R.L.S. 24599. Also found a previously blazed spruce northeast of corner which matches distance shown in liber 1, page 366, to what appears to be mistakenly labeled a 8" pine. The bearing to the pine also appears to be mistakenly shown as Northwest instead of Northeast. Accepted corner position as found and replaced pipe with a 3/4" x 48" rebar and aluminum Chippewa County Remonumentation cap. Laid 2" pipe next to 3/4" rebar.

C. Description of monument for corner and accessories established to perpetuate locating the position of the corner:

A-13 (T45N, R1W)

Corner is a 3/4" x 48" rebar with 3 1/4" aluminum Chippewa County Remonumentation cap. Witnesses:

6" Balsam Fir, N04°E 45.08'

10" Spruce, N46°E 33.98'

11" Spruce, S63°E 35.74'

5" White Birch, S46°W 21.13'

Note: Distances are to a nail and tag in the side of the tree. Trees are blazed a and painted. Bearings are compass bearings corrected for declination.

Signed by Keith R. Waters

Date 12-1-94

Surveyor's Michigan License No. 33142