## LAND CORNER RECORDATION CERTIFICATE Filing Requirement of Act 74, Mich. P.A. 197000 LAND CORNER

Chippewa County Remonumentation Corner

For corners in

Chippewa County	Loca	ted in:		Corner Code #
1. Public Land Survey		T44N T T T	R1W R R R	K-2 ,
<ul><li>2. Property Controlling in Section</li><li>3. Miscellaneous</li></ul>	S S S	T T T	R S 存MOI	URVEY & NUMENTATION
Property in Sec.	S	T	R FE	B 2 3 2001

\$2.00 MSSR 2 FEB 2001 3:51:00 PM Receipt #1103 RECEIVED FOR RECORD CHIPPEWA COUNTY - STATE OF MICHIGAN SHARON H. KENNEDY, REGISTER OF DEEDS

BOOK 11 PAGE 197

С D

Register of Deeds Stamp & File Number F

4 Lot No

 
, Recorded Plat

Private Claims

SECTION

I, Keith R. Waters, in a field survey on November 6, 2000, do hereby state that under requirements of P.A. 74, Michigan P.A. of 1970, the corner points mentioned in lines 1 and 2 above were in conformance with regulations and rules therefore as required in the current manual of survey instructions of the United States Department of the Interior, Bureau of Land Management or by a decree of a Court of Law and for that the corner points mentioned in lines 3, 4 and 5 above were in conformance with the rules of the Michigan Board of Land Surveyors or by a Decree of a Court of Law; established, re-established, monumented, recovered, found as expressed below:


NOTE: Not more than 2 corners, all in the same town and range, may be recorded on this certificate.



## K-2 1/4 Corner Common to Sections 1 & 2, T44N, R1W.

1845 - Original corner established by James H. Mullett. Witnesses: Hemlock 18, S85°E 10 links - Hemlock 24, S58°E 12 links.

Found no evidence of subsequent restoration of this corner.

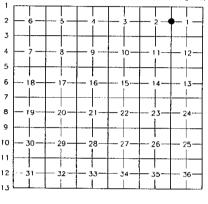



B. Description of corner evidence found and/or method applied in restoring or reestablishing corner:

This comer is being reestablished as part of the Chippewa County Remonumentation Program. Found no evidence of the original corner. Reestablished corner by single proportionale measurement on line between the closing section corner on the township line at K-1 to the north and the section corner at K-3 to the south.

C. Description of monument for corner and accessories established to perpetuate locating the position of the corner:

Placed a ¾" x 24" rebar with a stamped aluminum Chippewa County Remonumentation cap the corner location. Witnesses:

Nail and plastic witness tag #33142 in blazed 10" Cedar, N21°W 47.93

Nail and plastic witness tag #33142 in blazed 12" Spruce, N80°E 38.33'

Nail and plastic witness tag #33142 in blazed 6" Spruce, S25°E 22.82'

Nail and plastic witness tag #33142 in blazed 12" Spruce, S44°W 33.63'



Signed by Keith R. Wat

12-29-00

Surveyor's Michigan License No. 33142

FORM APPROVED BY MICHIGAN STATE BOARD OF PROFESSIONAL SURVEYORS, JAN. 28, 1971 REVISED MAY 14, 1975 REVISED JAN., 1983