

SURVEY & REMONUMENTATION

APR 26 1995

COMMISSION

CHIPPEWA COUNTY REMONUMENTATION CORNER

LAND CORNER RECORDATION CERTIFICATE

Filing Requirement of Act 74, Mich. P.A. 1970

For corners in

Chippewa

(County)

Located In:

Corner Code =#

1. Public Land Survey

T 44N R 2W

C-1

2. Property Controlling
in Section

S T R

3. Miscellaneous
Property in Sec.

S T R

4. Lot No. , Recorded Plat

5. Private Claims

\$ 7.00 LAND CORNER

\$ 2.00 HSSR

19 DEC 94 10:20 A.M. RECEIPT# 1769

RECEIVED FOR RECORD

CHIPPEWA COUNTY - STATE OF MICHIGAN
SHARON H. KENNEDY, REGISTER OF DEEDS

Register of Deeds Stamp & File Number

I, William L. Karr, in a field survey on November 21, 19 94

do hereby certify that under requirements of P.A. 74, Michigan P.A. of 1970, the corner points mentioned in lines 1 and 2 above were in conformance with regulations and rules therefore as required in the current manual of survey instructions of the United States Department of the Interior, Bureau of Land Management or by a decree of a Court of Law and/or that the corner points mentioned in lines 3, 4 and 5 above were in conformance with the rules of the Michigan Board of Land Surveyors or by a Decree of a Court of Law; established, re-established, monumented, re-monumented, recovered, found as expressed below:

NOTE: Not more than 4 corners, all in the same town and range, may be recorded on this certificate.

A. Description of original monument and accessories and/or subsequent restoration:

(C-1) Closing Corner 6/5, T.44 N., R.2 W.

1845:

Cedar 8 S57W 37 lks

Spruce 6 S65E 28 lks

B. Description of corner evidence found and/or method applied in restoring or reestablishing corner:

(C-1) This corner is being perpetuated as part of the Chippewa County Remonumentation program.

Found no evidence of original corner. Found a pk nail in the centerline of Tilson Road. The pk nail location has been used in previous surveys as the Closing Corner and represents the location of an iron or pipe prior to road construction on Tilson. The distance West to the North 1/4 Corner of Section 6 is 2649.46'. County Surveyor notes show this to be 2648' (early 1900's). The distance South to the Southeast corner of Section 6 is 5338.86'. The same County Surveyor notes show this to be 5337'. Accepted the pk nail as the best available evidence and set a 3/4"x 24" iron.

C. Description of monument for corner and accessories established to perpetuate locating the position of the corner:

(C-1) Corner is a 3/4"x 24" iron with plastic "Chippewa County Remonumentation" cap in the centerline of Tilson Road and 3' North of the centerline of an East-West road.

Witnesses: "v" notch in end of cmp

P. Pole

P. Pole

P. Pole (E-7001)

20" Cottonwood

N54°E 34.20'

N59°E 58.42'

S54°E 59.04'

S50°W 47.04'

N58°W 58.85

Signed by

William L. Karr



Date

12/9/94

Surveyor's Michigan License No. 27450

FORM APPROVED BY MICHIGAN STATE BOARD OF LAND SURVEYORS, JAN. 28, 1971
REVISED MAY 14, 1975
REVISED JAN., 1983

NOTE: Bearings are compass bearings corrected for declination.
Distances are to a nail in side of witness objects unless noted.

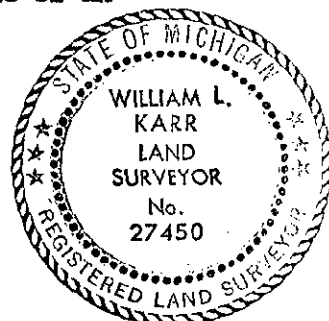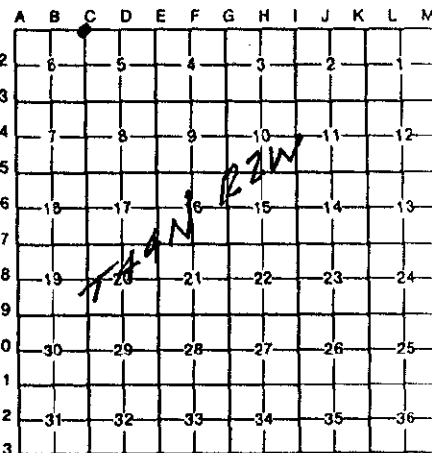

723-12