

CHIPPEWA COUNTY REMONUMENTATION CORNER

LAND CORNER RECORDATION CERTIFICATE
Filing Requirement of Act 74, Mich. P.A. 1970

For corners in

Chippewa

(County)

Located In:

Corner Code #

1. Public Land Survey

T44N R 2W #2 C/D-13 Same
T43N R 2W C/D-1 Corner2. Property Controlling
in Section

S T R

3. Miscellaneous
Property in Sec.

S T R

S T R

SURVEY &
REMONUMENTATION

22 1999

\$ 7.00 LAND CORNER

\$ 2.00 MSSR

28 FEB 96 4:32 P.M. RECEIPT# 459
RECEIVED FOR RECORDCHIPPEWA COUNTY - STATE OF MICHIGAN
SHARON H. KENNEDY, REGISTER OF DEEDS

Register of Deeds Stamp & File Number

4. Lot No. _____, Recorded Plat _____

5. Private Claims _____

I, Keith R. Waters, in a field survey on 12/19, 1995 do hereby state that under requirements of P.A. 74, Michigan P.A. of 1970, the corner points mentioned in lines 1 and 2 above were in conformance with regulations and rules therefore as required in the current manual of survey instructions of the United States Department of the Interior, Bureau of Land Management or by a decree of a Court of Law and/or that the corner points mentioned in lines 3, 4 and 5 above were in conformance with the rules of the Michigan Board of Land Surveyors or by a Decree of a Court of Law; established, re-established, monumented, recovered, found as expressed below:

NOTE: Not more than 2 corners, all in the same town and range, may be recorded on this certificate.

	A	B	C	D	E	F	G	H	I	J	K	L
1												
2	6		5		4		3		2		1	
3												
4	7		8		9		10		11		12	
5												
6	18		17		16		15		14		13	
7												
8	19		20		21		22		23		24	
9												
10	30		29		28		27		26		25	
11												
12	31		32		33		34		35		36	
13												

A. Description of original monument and accessories and/or subsequent restoration:

C/D-13 Meander Corner between Section 5, T43N, R2W & Section 32, T44N, R2W, on the East Bank of the Pine River

1840 - Original ties (William A. Burt): Elm 14, N80°E 08 links.

1989 - Richard L. Hays, P.S. 25847, as recorded in D-47, Mackinac County recorded corners. Corner was established on line between recovered corners at the S.W. corner of Section 31 and the S.E. corner of Section 32, T44N, R2W, at the proportionate distance east-west according to original GLO notes. Witnesses: 6" Ash, S37°W 15.16' - 13" Birch, S57°E 22.51' - 6" Fir, N63°E 15.28' Post, EAST 1.0'

B. Description of corner evidence found and/or method applied in restoring or reestablishing corner:

This corner is being perpetuated as part of the Chippewa County Remonumentation Program.

Found a 2 1/2" x 3" monument with a 3" aluminum cap stamped to identify the corner. Also found witness objects as called for in Mackinac County LCRC.

C. Description of monument for corner and accessories established to perpetuate locating the position of the corner:

Corner is a 2 1/2" x 3" monument with a stamped 3" aluminum cap. Witnesses:

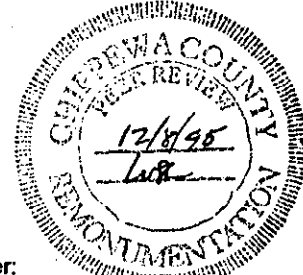
6" Ash, S37°W 15.16'

13" Birch, S57°E 22.51'

6" Balsam Fir, N63°E 15.28'

Post, EAST 1.0'

Note: Trees are blazed and painted. Distances are to nail blaze.

Signed by Keith R. WatersDate December 29, 1995Surveyor's Michigan License No. 33142