

SURVEY &  
REMONUMENTATION  
CHIPPEWA COUNTY REMONUMENTATION CORNER

MAR 09 1984

LAND CORNER RECORDATION CERTIFICATE  
Filing Requirement of Act 74, Mich. P.A. 1970

For corners in  
Chippewa  
(County)

Located In:

Corner Code #

1. Public Land Survey

T 45N R 1E L-7

2. Property Controlling  
in Section


S T

3. Miscellaneous  
Property in Sec.

S T

4. Lot No. , Recorded Plat

5. Private Claims

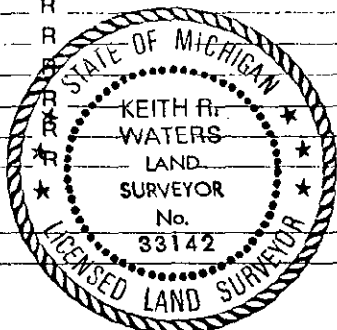

RECEIVED FOR RECORD  
CHIPPEWA COUNTY  
STATE OF MICHIGAN

93 DEC 30 PM 2:46

J. Roger Matlock  
REGISTER OF DEEDS

Register of Deeds Stamp & File Number

	A	B	C	D	E	F	G	H	I	J	K	L	M
2	6		5		4		3		2		1		
3													
4	7		8		9		10		11		12		
5													
6	18		17		16		15		14		13		
7													
8	19		20		21		22		23		24		
9													
10	30		29		28		27		26		25		
11													
12	31		32		33		34		35		36		
13													

6. Keith R. Waters in a field survey on November 24, 1993

I do hereby certify that under requirements of P.A. 74, Michigan P.A. of 1970, the corner points mentioned in lines 1 and 2 above were in conformance with regulations and rules therefore as required in the current manual of survey instructions of the United States Department of the Interior, Bureau of Land Management or by a decree of a Court of Law and/or that the corner points mentioned in lines 3, 4 and 5 above were in conformance with the rules of the Michigan Board of Land Surveyors or by a Decree of a Court of Law; established, re-established, monumented, re-monumented, recovered, found as expressed below:

NOTE: Not more than 4 corners, all in the same town and range, may be recorded on this certificate.

A. Description of original monument and accessories and/or subsequent restoration:

L-7 1/4 Corner Common to Sections 13 & 24, T45N, R1E

Original ties to post: Hemlock 18, S12°E 23 links Fir 10, N09°E 12 links

This corner is recorded in liber 6, page 90, of Chippewa County corner records by William L. Karr, P.S. 27450 (1984), as a 1½" pipe 3 feet north of centerline of road, position matching closely with County Surveyor notes.

Record ties: 18" White Pine, S49°E 112.68' 10" White Birch, S29°W 114.25' Power Pole (DR2/215), S02°E 50.69'

B. Description of corner evidence found and/or method applied in restoring or reestablishing corner:

L-7 (T45N, R1E)

This corner is being perpetuated as part of the Chippewa County Remonumentation Program.

Found an empty monument box 3.0 feet north of centerline of east-west asphalt road (15 Mile Road). 15 Mile Road has been repaved since previous recording. Reset corner in monument box using two remaining witnesses from previous recording (white pine and power pole). Distance to Section corner east is 2650.55 feet and distance to Section corner west is 2695.91 feet. Corner is 84.7 feet north of a straight line between said Section corners.

Description of monument for corner and accessories established to perpetuate locating the position of the corner:

L-7 (T45N, R1E)

Corner is a 3/4" rebar with plastic Chippewa County Remonumentation cap in a monument box 3.0 feet north of centerline of 15 Mile Road, 33'± east of centerline of gravel road to the south. Witnesses:

18" White Pine, S44°E 112.68'

Power Pole (DR2/215), S02°E 50.69'

11" Spruce, N56°E 123.79'

12" Maple, S50°W 115.61'

Note: Distances to 18" white pine and power pole are to a PK nail in side.

Distances to 11" spruce and 12"

maple are to a nail and witness tag in side. Bearings are compass bearings corrected for declination.

Signed by Keith R. Waters

Date 12-30-93

Surveyor's Michigan License No. 33142