

**SURVEY &  
REMONUMENTATION**

APR 26 1995

CHIPPEWA COUNTY REMONUMENTATION CORNER

**COMMISSION**

**LAND CORNER RECORDATION CERTIFICATE**

Filing Requirement of Act 74, Mich. P.A. 1970

For corners in

Chippewa

(County)

Located in:

Corner Code ##

1. Public Land Survey

T 45N R 1W

H-1

T \_\_\_\_\_ R \_\_\_\_\_

T \_\_\_\_\_ R \_\_\_\_\_

T \_\_\_\_\_ R \_\_\_\_\_

T \_\_\_\_\_ R \_\_\_\_\_

2. Property Controlling  
in Section

S \_\_\_\_\_ T \_\_\_\_\_ R \_\_\_\_\_

S \_\_\_\_\_ T \_\_\_\_\_ R \_\_\_\_\_

3. Miscellaneous

S \_\_\_\_\_ T \_\_\_\_\_ R \_\_\_\_\_

Property in Sec.

S \_\_\_\_\_ T \_\_\_\_\_ R \_\_\_\_\_

4. Lot No. \_\_\_\_\_, Recorded Plat \_\_\_\_\_

5. Private Claims \_\_\_\_\_

\$ 7.00 LAND CORNER

\$ 2.00 MSSR

5 DEC 94 12:26 P.M. RECEIPT# 1518

RECEIVED FOR RECORD

CHIPPEWA COUNTY - STATE OF MICHIGAN

SHARON H. KENNEDY, REGISTER OF DEEDS

Register of Deeds Stamp & File Number

I, William L. Karr, in a field survey on October 28, 19 94,  
do hereby certify that under requirements of P.A. 74, Michigan P.A. of 1970, the corner points mentioned  
in lines 1 and 2 above were in conformance with regulations and rules therefore as required in the  
current manual of survey instructions of the United States Department of the Interior, Bureau of Land  
Management or by a decree of a Court of Law and/or that the corner points mentioned in lines 3, 4 and 5  
above were in conformance with the rules of the Michigan Board of Land Surveyors or by a Decree of a  
Court of Law; established, re-established, monumented, re-monumented, recovered, found as  
expressed below:

**NOTE:** Not more than 4 corners, all in the same town and range, may be recorded  
on this certificate.

A. Description of original monument and accessories and/or subsequent restoration:

(H-1) North 1/4 Corner Section 3, T.45 N., R.1 W. (Not common)

Not set in original survey.

B. Description of corner evidence found and/or method applied in restoring or reestablishing corner:

(H-1) This corner is being established as part of the Chippewa County Remonumentation  
program.

Corner was established mid-way between C.C. 3/2 and C.C. 4/3 on the Township  
line. Corner falls 19.80' East of the South 1/4 corner of Section 34. (GLO-19.80')

C. Description of monument for corner and accessories established to perpetuate locating the position of the corner:

(H-1) Corner is a 3/4"x 24" iron with plastic "Chippewa County Remonumentation"  
cap, 17' East of the centerline of a road to the North and 24' North of the  
centerline of a 12 Mile Road to the East.



Witnesses: P. Pole	N10°E	103.03'
P. Pole	S10°E	69.67'
15" Spruce	S71°W	61.30'
12" Tamarack	N83°W	83.45'
South 1/4 Corner Section 34	West	19.80'

Signed by William L. Karr Date 12/2/94

Surveyor's Michigan License No. 27450

**NOTE:** Bearings are compass bearings corrected for declination.  
Distances are to a nail in side of witness objects unless noted.

	A	B	C	D	E	F	G	H	I	J	K	L	M
2	6		5		4			3		2			
3													
4	7		8		9			10		11			12
5													
6	18		17		16			15		14			13
7													
8	19		20		21			22		23			24
9													
10	30		29		28			27		26			25
11													
12	31		32		33			34		35			36
13													

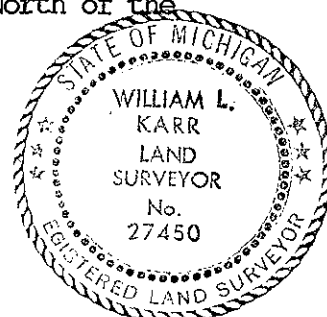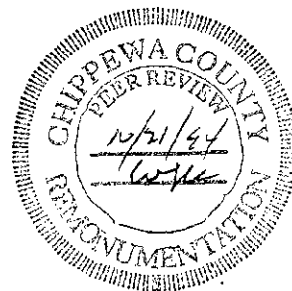

723-12

FORM APPROVED BY MICHIGAN STATE BOARD OF LAND SURVEYORS, JAN. 28, 1971

REVISED MAY 14, 1975

REVISED JAN., 1983