

1993

CHIPPEWA COUNTY REMONUMENTATION CORNER

RECEIVED FOR RECORD
CHIPPEWA COUNTY
STATE OF MICHIGAN

COMMISSION

LAND CORNER RECORDATION CERTIFICATE

Filing Requirement of Act 74, Mich. P.A. 1970

93 DEC -3 PM 3:58

For corners in
Chippewa

(County)

Located In:

Corner Code #

1. Public Land Survey	T45N R 1E	A-2	Same
	T45N R 1W	M-2	Corner
	T _____ R _____		
	T _____ R _____		
2. Property Controlling in Section	S _____ T _____ R _____		
	S _____ T _____ R _____		
3. Miscellaneous Property in Sec.	S _____ T _____ R _____		
	S _____ T _____ R _____		

J. Roger Madole
REGISTER OF DEEDS

Register of Deeds Stamp & File Number

4. Lot No. _____, Recorded Plat _____
5. Private Claims _____

I, Keith R. Waters in a field survey on June 3, 1993 do hereby certify that under requirements of P.A. 74, Michigan P.A. of 1970, the corner points mentioned in lines 1 and 2 above were in conformance with regulations and rules therefore as required in the current manual of survey instructions of the United States Department of the Interior, Bureau of Land Management or by a decree of a Court of Law and/or that the corner points mentioned in lines 3, 4 and 5 above were in conformance with the rules of the Michigan Board of Land Surveyors or by a Decree of a Court of Law; established, re-established, monumented, re-monumented, recovered, found as expressed below:

NOTE: Not more than 4 corners, all in the same town and range, may be recorded on this certificate.

A. Description of original monument and accessories and/or subsequent restoration:

A-2 (T45N, R1E)
1/4 Corner Common to Section 6, T45N, R1E & Section 1, T45N, R1W

Corner recorded by Neil E. Hill, P.S. 27447, in liber 7, page 30, of Chippewa County corner records (5-21-1987) as a iron with cap 27447 in a monument box with the following ties:

- End Fence Post, East 75.85'
- Fence Post, N60°E 87.09'
- Mailbox Post, S75°W 21.89'
- Top Center of Steel Post behind Telephone Pedestal, S65°W 63.02'


B. Description of corner evidence found and/or method applied in restoring or reestablishing corner:

A-2 (T45N, R1E)
This corner is being perpetuated as part of the Chippewa County Remonumentation Program.
Found iron with cap 27447 in a monument box in centerline of Highway M-129. Steel post behind telephone pedestal is the only witness from 1987 records that is still intact. Fence posts have fallen down and mailbox post is gone. Accepted corner as found and established three new witness objects.

C. Description of monument for corner and accessories established to perpetuate locating the position of the corner:

A-2 (T45N, R1E)
Corner is a iron with cap 27447 in a monument box in the centerline of Highway M-129. Witnesses:
Power Pole (DR2-96-1), N19°E 236.36'
Power Pole (DR2-97), S38°E 121.93'
Highway Dept. R.O.W. Marker iron in Monument Box, North 225.32'
Center of Steel Post behind Telephone Splice Box, S70°W 62.91'

Note: Measurements to poles are to a nail and tag in the side. Distances measured with EDM. Bearings are compass bearings corrected for declination.

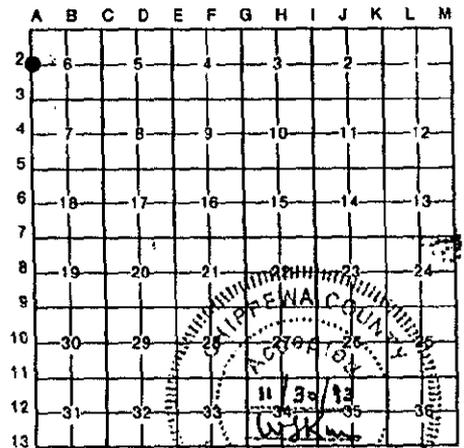

Signed by Keith R. Waters Date 11-30-93

Surveyor's Michigan License No. 33142