

MAR 09 1994

CHIPPEWA COUNTY REMONUMENTATION CORNER

RECEIVED FOR RECORD  
CHIPPEWA COUNTY  
STATE OF MICHIGAN

93 DEC 30 PM 2:44

COMMISSION

LAND CORNER RECORDATION CERTIFICATE

Filing Requirement of Act 74, Mich. P.A. 1970

For corners in  
Chippewa

(County)

Located In:

Corner Code ##

1. Public Land Survey

T45N R 2E

B-1/C-1 Same

T46N R 2E

B-13/C-13 Corner

T R

Other

T R

#3

2. Property Controlling  
in Section

S T R

S T R

3. Miscellaneous

S T R

Property in Sec.

S T R

J. Roger Malott  
REGISTER OF DEEDS

Register of Deeds Stamp & File Number

4. Lot No. , Recorded Plat

5. Private Claims

	A	B	C	D	E	F	G	H	I	J	K	L	M
2	6	5	4	3	2	1							
3													
4	7	8	9	10	11	12							
5													
6	18	17	16	15	14	13							
7													
8	19	20	21	22	23	24							
9													
10	30	29	28	27	26	25							
11													
12	31	32	33	34	35	36							
13													

Keith R. Waters

December 16 93

I, in a field survey on , 19 , do hereby certify that under requirements of P.A. 74, Michigan P.A. of 1970, the corner points mentioned in lines 1 and 2 above were in conformance with regulations and rules therefore as required in the current manual of survey instructions of the United States Department of the Interior, Bureau of Land Management or by a decree of a Court of Law and/or that the corner points mentioned in lines 3, 4 and 5 above were in conformance with the rules of the Michigan Board of Land Surveyors or by a Decree of a Court of Law; established, re-established, monumented, re-monumented, recovered, found as expressed below:

NOTE: Not more than 4 corners, all in the same town and range, may be recorded on this certificate.

A. Description of original monument and accessories and/or subsequent restoration:

B-1/C-1 (T45N, R2E) Meander Corner Common to Section 6, T45N, R2E and Section 31, T46N, R2E.

Original meander post was set in marsh, 18 chains (1188 feet) east of 1/4 corner common to Section 6, T45N, R2E and Section 31, T46N, R2E. No trees were available for witnesses.

B. Description of corner evidence found and/or method applied in restoring or reestablishing corner:

B-1/C-1 (T45N, R2E)

This corner is being re-established as part of the Chippewa County Remonumentation Program. Found no evidence of corner. Re-established corner 1188.00 feet east of the 1/4 corner between Section 6, T45N, R2E and Section 31, T46N, R2E, on line with Township corner 2640.00 feet west of said 1/4 corner. Corner falls in the centerline of a 2-track causeway built into marshy area along the shore of Lake Nicolet. Corner is approximately 230 feet east of the east end of east-west gravel road (12 Mile Road), and is approximately 280 feet west of end of said east-west 2-track causeway.



- Description of monument for corner and accessories established to perpetuate locating the position of the corner:

B-1/C-1 (T45N, R2E)

Corner is a 3/4" x 24" rebar with 3 1/4" aluminum Chippewa County Remonumentation cap in the centerline of an east-west 2-track causeway. Witnesses:

Power Pole (49N), N70°W 89.66'  
9" Black Ash, N59°W 64.57'  
6" Black Ash, N25°W 27.85'  
NE Corner of Wood Frame Garage,  
S85°W 316.38'

Note: Unless noted otherwise, distances are to a nail and tag in the side of the witness object. Trees are blazed and painted. Bearings are compass bearings corrected for declination. Distances are measured with EDM.

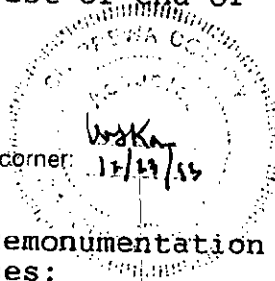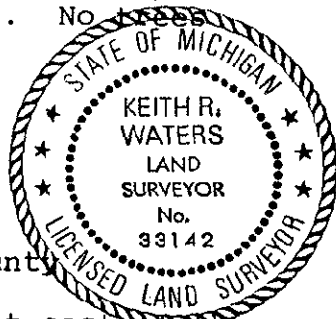

igned by Keith R. Waters

Date 12-30-93

urveyor's Michigan License No. 33142