

MAY 28 1997

CHIPPEWA COUNTY REMONUMENTATION CORNER

COMMISSION

LAND CORNER RECORDATION CERTIFICATE

Filing Requirement of Act 74, Mich. P.A. 1970 \$7.00 LAND CORNER

For corners in

Chippewa

(County)

Located In:

Corner Code #

1. Public Land Survey

T46N R 2W

C-1/C-2

T R

T R

T R

T R

2. Property Controlling
in Section

S

T R

S

T R

3. Miscellaneous
Property in Sec.

S

T R

S

T R

#3
Other

\$2.00 MSSR

3/4/1997 2:00:49 PM

Receipt #294

RECEIVED FOR RECORD

CHIPPEWA COUNTY - STATE OF MICHIGAN

SHARON H. KENNEDY, REGISTER OF DEEDS

BOOK 10 PAGE 58

Register of Deeds Stamp & File Number

4. Lot No. , Recorded Plat

5. Private Claims

I, William L. Karr, in a field survey on Nov. 26, 1996 do hereby state that under requirements of P.A. 74, Michigan P.A. of 1970, the corner points mentioned in lines 1 and 2 above were in conformance with regulations and rules therefore as required in the current manual of survey instructions of the United States Department of the Interior, Bureau of Land Management or by a decree of a Court of Law and/or that the corner points mentioned in lines 3, 4 and 5 above were in conformance with the rules of the Michigan Board of Land Surveyors or by a Decree of a Court of Law; established, re-established, monumented, recovered, found as expressed below:

NOTE: Not more than 2 corners, all in the same town and range, may be recorded on this certificate.



	A	B	C	D	E	F	G	H	I	J	K	L	M
1													
2	6		5		4		3		2		1		
3													
4	7		8		9		10		11		12		
5													
6	18		16		16		15		14		13		
7													
8	19		20		21		22		23		24		
9													
10	30		29		28		27		26		25		
11													
12	31		32		33		34		35		36		
13													

A. Description of original monument and accessories and/or subsequent restoration

(C-1/C-2) Witness Corner to the Meander Corner (W.C.M.C.) Common to Sections 5 & 6, T.46 N., R.2 W.

1849: H. Mellen set post Cedar 8 S4-1/2°E 36 Hemlock 20 S52°W 54

1945: R.H. Larsen recorded the Stewart Plat of Wasika Bay in Liber 5 of Plats, Page 12.

1975: Dependent resurvey by U.S. Department of Interior re-established corner.

1976: N.D. Alix, P.S. 6254 found 2" dia. galvanized pipe with 4" brass cap and accepted. Corner was recorded in Liber 1, Page 218 of the Chippewa County Corner Records.

B. Description of corner evidence found and/or method applied in restoring or reestablishing corner:


(C-1/C-2) This Corner is being perpetuated as part of the Chippewa County Remonumentation Program.

Found no evidence of original corner. Found Department of Interior brass capped pipe. This position is consistent and works well with interior monumentation of the Stewart Plat of Waika Bay. Accepted corner position as found and added witnesses.

C. Description of monument for corner and accessories established to perpetuate locating the position of the corner:

(C-1/C-2) Corner is a 2-1/4" iron pipe with Department Interior brass cap 6" above ground. Corner falls 2' South of lake bluff top.

Witnesses:	Nail & tag in 3rd step down on stairs to water's edge	S67°E	11.41'
	Power pole	S12°E	11.22'
	6" Maple	S31°W	12.10'
	10" Maple (with scar at base)	S86°W	27.20'

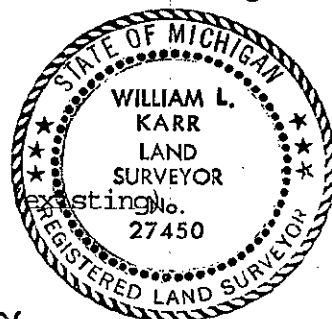

Signed by William L. Karr
Surveyor's Michigan License No. 27450

Date 12-30-96

NOTE: All bearings are compass bearings corrected

for declination. All distances are to a nail in side of witness objects unless noted.