

SURVEY & REMONUMENTATION

MAR 09 1994

Chippewa County Remonumentation Corner

LAND CORNER RECORDATION CERTIFICATE Filing Requirement of Act 74, Mich. P.A. 1970

RECEIVED FOR RECORD
CHIPPEWA COUNTY
STATE OF MICHIGAN

93 DEC 14 PM 4:26

COMMISSION

For corners in

Chippewa

(County)

Located In:

Corner Code #

1. Public Land Survey

T 46N R 1E

D-5

2. Property Controlling
in Section

3. Miscellaneous

Property in Sec.

4. Lot No. , Recorded Plat

5. Private Claims

J. Roger Malott
REGISTER OF DEEDS

Register of Deeds Stamp & File Number

I, William L. Karr, in a field survey on November 22, 1993

do hereby certify that under requirements of P.A. 74, Michigan P.A. of 1970, the corner points mentioned in lines 1 and 2 above were in conformance with regulations and rules therefore as required in the current manual of survey instructions of the United States Department of the Interior, Bureau of Land Management or by a decree of a Court of Law and/or that the corner points mentioned in lines 3, 4 and 5 above were in conformance with the rules of the Michigan Board of Land Surveyors or by a Decree of a Court of Law; established, re-established, monumented, re-monumented, recovered, found as expressed below:

NOTE: Not more than 4 corners, all in the same town and range, may be recorded on this certificate.

A. Description of original monument and accessories and/or subsequent restoration:

(D-5) 1/4 Corner Common to Sections 8 & 17, (T46N-R1E)

This corner was recorded by Keith R. Waters, L.S. 33142 in Liber 7, Page 249 of the Chippewa County Corner Records as a 1/2" iron with cap #33142 with the following witnesses:

6" Spruce	N75°W	86.64'
Fence Post	S76°W	43.49'
Fence Post	S27°E	69.20'
Fence Post	N54°E	44.08'

B. Description of corner evidence found and/or method applied in restoring or reestablishing corner:



(D-5) This corner is being perpetuated as part of the Chippewa County Remonumentation Program.

Found 1/2" iron with cap #33142 and three witnesses. Accepted corner position as found and added one witness.

C. Description of monument for corner and accessories established to perpetuate locating the position of the corner:

(D-5) Corner is a 1/2" x 18" iron with cap #33142. Falls 5' South of the centerline of Eight Mile Road (gravel) and 2' West of extension of fence line to the North and on extension of fence line to South.

Witnesses: 6" Spruce	N77°W	86.58'
Fence Post	S55°E	69.11'
Fence Post	N50°E	44.27'
7" Spruce	N80°W	185.23'

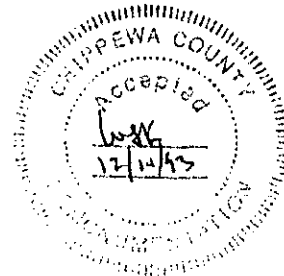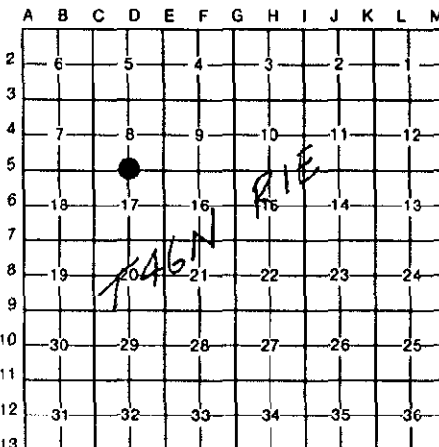

Signed by William L. Karr

Date 12/14/93

Surveyor's Michigan License No. 27450

NOTE: Bearings are compass bearings corrected for declination.

Distances are to a nail in side of witness objects unless noted.