

MAR 09 1994

Chippewa County Remonumentation Corner

RECEIVED FOR RECORD
CHIPPEWA COUNTY
STATE OF MICHIGAN

COMMISSION

LAND CORNER RECORDATION CERTIFICATE
Filing Requirement of Act 74, Mich. P.A. 1970

93 DEC 14 PM 4: 26

For corners in

Chippewa

(County)

Located In:


Corner Code --#

1. Public Land Survey	T	46N	R	1E	F-3
	T		R		
	T		R		
	T		R		
2. Property Controlling in Section	S		T	R	
	S		T	R	
3. Miscellaneous Property in Sec.	S		T	R	
	S		T	R	

J. Roger Mallett
REGISTER OF DEEDS

Register of Deeds Stamp & File Number

- 4. Lot No. _____, Recorded Plat _____
- 5. Private Claims _____

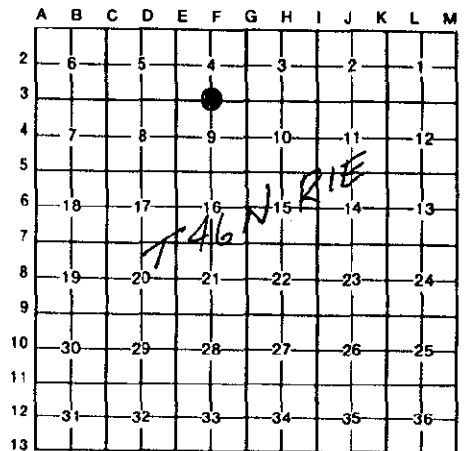


I, William L. Karr, in a field survey on November 29, 1993, do hereby certify that under requirements of P.A. 74, Michigan P.A. of 1970, the corner points mentioned in lines 1 and 2 above were in conformance with regulations and rules therefore as required in the current manual of survey instructions of the United States Department of the Interior, Bureau of Land Management or by a decree of a Court of Law and/or that the corner points mentioned in lines 3, 4 and 5 above were in conformance with the rules of the Michigan Board of Land Surveyors or by a Decree of a Court of Law; established, re-established, monumented, re-monumented, recovered, found as expressed below:

NOTE: Not more than 4 corners, all in the same town and range, may be recorded on this certificate.

A. Description of original monument and accessories and/or subsequent restoration:

(F-3) 1/4 Corner Common to Sections 4 & 9, (T46N-R1E)

1845: James H. Mullett, D.S.
Set Post.
Fir 10 S33°W 13 links
Cedar 12 N26°W 10 links

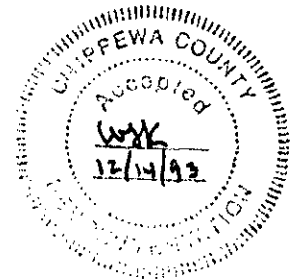

B. Description of corner evidence found and/or method applied in restoring or reestablishing corner:

(F-3) This corner is being re-established as part of the Chippewa County Remonumentation Program.

Found no evidence of original corner. Found 1/2" iron in approximate centerline of Seven Mile Road on extension of fence line to the North. County Surveyor notes indicate an overall distance of 5310' for this mile (5315.74 measured today) with 2653 for the East 1/2 mile and 2657 for the West 1/2 mile. The found 1/2" iron falls 3.47' South of a straight line between the Section corners. Using the found 1/2" iron, the East 1/2 mile measures 2654.10 (2653 CS) and the West 1/2 mile measures 2661.64 (2657 CS). Accepted corner position as found. Replaced with 3/4" iron and added four witnesses.

C. Description of monument for corner and accessories established to perpetuate locating the position of the corner:

(F-3) Corner is a 3/4" x 24" iron with stamped aluminum cap (Chippewa County Remonumentation) in approximate centerline of Seven Mile Road and on extension of fences to the North and South.

Witnesses: 3rd Post East of Fence Corner N36°E 60.83'
1" iron pipe (pinched top) S45°E 45.00'
4" White Birch S77°W 144.53'
4th Post West of Fence Corner N37°W 62.08'



Signed by William L. Karr Date 12/14/93

Surveyor's Michigan License No. 27450

NOTE: Bearings are compass bearings corrected for declination. Distances are to a nail in side of witness objects unless noted.