

SURVEY &  
REMONUMENTATION

APR 27 1995

CHIPPEWA COUNTY REMONUMENTATION CORNER

COMMISSION

LAND CORNER RECORDATION CERTIFICATE

Filing Requirement of Act 74, Mich. P.A. 1970

For corners in

Chippewa

(County)

Located In:

Corner Code ##

1. Public Land Survey

T 46N R 1E

K-4

T R

T R

T R

2. Property Controlling  
in Section

S T R

S T R

3. Miscellaneous

S T R

Property in Sec:

S T R

4. Lot No. , Recorded Plat

5. Private Claims

\$ 7.00 LAND CORNER

\$ 2.00 MSSR

5 DEC 94 12:09 P.M. RECEIPT# 1517

RECEIVED FOR RECORD

CHIPPEWA COUNTY - STATE OF MICHIGAN

SHARON H. KENNEDY, REGISTER OF DEEDS

Register of Deeds Stamp & File Number

I, William L. Karr, in a field survey on October 20, 19 94,  
do hereby certify that under requirements of P.A. 74, Michigan P.A. of 1970, the corner points mentioned  
in lines 1 and 2 above were in conformance with regulations and rules therefore as required in the  
current manual of survey instructions of the United States Department of the Interior, Bureau of Land  
Management or by a decree of a Court of Law and/or that the corner points mentioned in lines 3, 4 and 5  
above were in conformance with the rules of the Michigan Board of Land Surveyors or by a Decree of a  
Court of Law; established, re-established, monumented, re-monumented, recovered, found as  
expressed below:

**NOTE: Not more than 4 corners, all in the same town and range, may be recorded  
on this certificate.**

A. Description of original monument and accessories and/or subsequent restoration:

(K-4) 1/4 Corner of Sections 11 & 12, T.46 N., R.1 E.

1845: J. Mullett marked a Birch 8" for 1/4 Section corner.

1984 W.L. Karr found a 1" pipe in concrete as referenced in "Eagle's Idlewild  
Plat" (L.7 of plats P.9) and was recorded in L.6 of corners, P.107.

|                  |      |        |
|------------------|------|--------|
| Witnesses: Pole  | N42W | 45.22' |
| Cen-top Bell Box | S40E | 41.66' |
| Mi.Bell sign     | S64W | 53.44' |

B. Description of corner evidence found and/or method applied in restoring or reestablishing corner:


(K-4) This corner is being perpetuated as part of the Chippewa County Remonumentation  
program.

Found no evidence of original corner. Found 1" pipe in concrete as previously  
recorded and (1) record witness. Accepted corner position as found.

C. Description of monument for corner and accessories established to perpetuate locating the position of the corner:

(K-4) Corner is a 1" pipe set in concrete on the extension of centerlines of 7-1/2  
Mile Road to the West and Lower Hay Lake Road to the South.

|                                  |       |        |
|----------------------------------|-------|--------|
| Witnesses: P. Pole               | N40°W | 45.25' |
| 6" Aspen                         | S66°W | 79.03' |
| 1" capped pipe 1.5' below ground | N49°E | 57.03' |
| 1" capped pipe 1.5' below ground | S42°E | 51.90' |

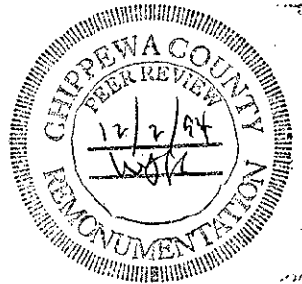

Signed by

*William L. Karr*

Date

12/2/94

Surveyor's Michigan License No. 27450

723-12

NOTE: Bearings are compass bearings corrected for declination.  
Distances are to a nail in side of witness objects unless noted.

FORM APPROVED BY MICHIGAN STATE BOARD OF LAND SURVEYORS, JAN. 28, 1971  
REVISED MAY 14, 1975  
REVISED JAN., 1983