

CHIPPEWA COUNTY REMONUMENTATION CORNER

LAND CORNER RECORDATION CERTIFICATE REMONUMENTATION

Filing Requirement of Act 74, Mich. P.A. 1970

SURVEY &

JUL 22 1999

For corners in

Chippewa

(County)

Located In:

Corner Code =#

SECTION

1. Public Land Survey

T 46N R 1E

K-5/L-5 #3

T R

T R

T R

2. Property Controlling
in Section

S T R

S T R

3. Miscellaneous

S T R

Property in Sec.

S T R

\$ 7.00 LAND CORNER

\$ 2.00 MSSR

5 DEC 94 12:09 P.M. RECEIPT# 1517

RECEIVED FOR RECORD

CHIPPEWA COUNTY - STATE OF MICHIGAN

REGISTERED LAND SURVEYOR

4. Lot No. , Recorded Plat

5. Private Claims

1. William L. Karr in a field survey on October 20 19 94

do hereby certify that under requirements of P.A. 74, Michigan P.A. of 1970, the corner points mentioned in lines 1 and 2 above were in conformance with regulations and rules therefore as required in the current manual of survey instructions of the United States Department of the Interior, Bureau of Land Management or by a decree of a Court of Law and/or that the corner points mentioned in lines 3, 4 and 5 above were in conformance with the rules of the Michigan Board of Land Surveyors or by a Decree of a Court of Law; established, re-established, monumented, re-monumented, recovered, found as expressed below:


NOTE: Not more than 4 corners, all in the same town and range, may be recorded on this certificate.

A. Description of original monument and accessories and/or subsequent restoration:

(K-5/L-5) Meander Corner Sections 12 & 13, T.46 N., R.1 E.

1845: J. Mullett set meander post 32.5 chains (2145') East of Section corner at river. Willow 8 N75W 32
Willow 6 S22W 60

	A	B	C	D	E	F	G	H	I	J	K	L
2	6	5	4	3	2							
3												
4	7	8	9	10	11							
5												
6	18	17	16	15	14							
7												
8	19	20	21	22	23	24						
9												
10	30	29	28	27	26	25						
11												
12	31	32	33	34	35	36						
13												

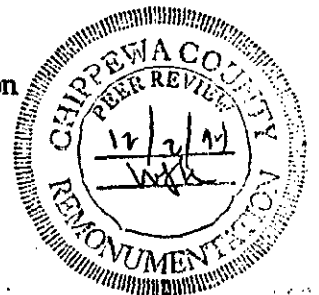

B. Description of corner evidence found and/or method applied in restoring or reestablishing corner:

(K-5/L-5) This corner is being re-established as part of the Chippewa County Remonumentation program.

Found no evidence of corner position.


Corner was re-established using monumentation from the "York Plat of the Elms". Original Meander Corners falls in the St. Mary's River. A "Witness Corner to the Meander Corner" was established 2015.07' East of the Section corner (130' West of the GLO position). Set a 3/4"x 24" iron.

C. Description of monument for corner and accessories established to perpetuate locating the position of the corner:

(K-5/L-5) Witness Corner to the Meander Corner is a 3/4"x 24" iron with stamped aluminum cap set 130' West of GLO position on the Section line.

Witnesses: N.E. corner "York Plat of the Elms" (1" iron in concrete)
S.E. corner conc. block foundation
USCE Monument (C4W-163)
3/4" pipe
1" pipe

N15°W 203.75'
N80°W 286.82'
S34°E 31.94'
S68°E 15.84'
S41°E 22.93'

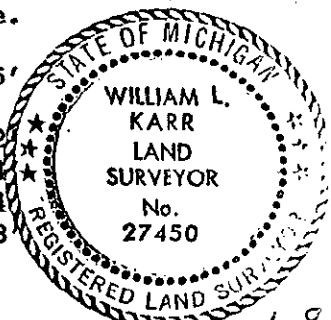

Signed by

William L. Karr

Date

12/2/94

723-12

Surveyor's Michigan License No. 27450

NOTE: Bearings are compass bearings corrected for declination.

Distances are to a nail in side of witness objects unless noted. Other code: 3

FORM APPROVED BY MICHIGAN STATE BOARD OF LAND SURVEYORS, JAN. 28, 1971
REVISED MAY 14, 1975L. 8
Pg 40