

MAR 18 1999

LAND CORNER RECORDATION CERTIFICATE  
Filing Requirement of Act 74, Mich. P.A. 1970  
Chippewa County Remonumentation Corner

SECTION

For corners in

Chippewa

Located In:

Corner Code #

1. Public Land Survey

T 46N R 2E

A/B-3

T R

T R

T R

T R

2. Property Controlling  
in Section

S T R

S T R

3. Miscellaneous  
Property in Sec.

S T R

S T R

4. Lot No. , Recorded Plat

5. Private Claims

I, Larry R. Rogers in a field survey on November 25, 1998, do hereby state that under requirements of P.A. 74, Michigan P.A. of 1970, the corner points mentioned in lines 1 and 2 above were in conformance with regulations and rules therefore as required in the current manual of survey instructions of the United States Department of the Interior, Bureau of Land Management or by a decree of a Court of Law and/or that the corner points mentioned in lines 3, 4 and 5 above were in conformance with the rules of the Michigan Board of Land Surveyors or by a Decree of a Court of Law; established, re-established, monumented, recovered, found as expressed below:

NOTE: Not more than 2 corners, all in the same town and range, may be recorded on this certificate.

A. Description of original monument and accessories and/or subsequent restoration:

(A/B-3) Meander Corner between Sections 6 and 7, Township 46 North, Range 2 East.

The original corner was placed in 1845 by James H. Mullett. County Surveyor records make no specific reference to this corner. A 1975 B.L.M. dependent resurvey determined that the meander corner now falls in the St. Mary's River - no witness corner was set.

B. Description of corner evidence found and/or method applied in restoring or reestablishing corner:

(A/B-3) Meander Corner between Sections 6 and 7, Township 46 North, Range 2 East.

This corner is being perpetuated as part of the Chippewa County Remonumentation Program.

Found no evidence of original corner position. The corner position was re-established by extending the South line of Section 6 from the Southeast corner through the South 1/4 corner, the record G.L.O. distance (858 feet) West from said 1/4 corner. The corner does not fall in the St. Mary's River.

C. Description of monument for corner and accessories established to perpetuate locating the position of the corner:

(A/B-3) Meander Corner between Sections 6 and 7, Township 46 North, Range 2 East.

Corner is a 3/4" x 24" iron with stamped aluminum cap set flush with the ground on the Easterly margin of low area leading to the St. Mary's River.

Witnesses:

8" Red Oak N06°W 17.89 feet

10" Red Oak N79°E 40.76 feet

24" Ash S51°E 41.42 feet

8" Ash S10°W 25.81 feet

St. Mary's River West 130.00 feet more or less

Steel Fence Post North 2.0 feet

\$7.00 LAND CORNER

\$2.00 MSSR

21 JAN 1999 10:24:10 AM Receipt #13123


RECEIVED FOR RECORD

CHIPPEWA COUNTY - STATE OF MICHIGAN  
SHARON H. KENNEDY, REGISTER OF DEEDS

BOOK 10 PAGE 347

Register of Deeds Stamp & File Number

1	A	B	C	D	E	F	G	H	I	J	K	L	M
2		6		5		4		3		2		1	
3													
4		7		8		9		10		11		12	
5													
6		18		17		16		15		14		13	
7													
8		19		20		21		22		23		24	
9													
10		30		29		28		27		26		25	
11													
12		31		32		33		34		35		36	
13													

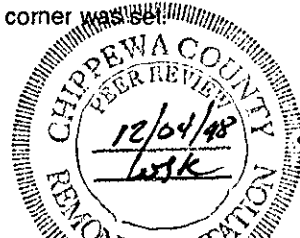

Signed by

Date 30 DEC 1998

Surveyor's Michigan License No. 29251

NOTE: All bearings are compass bearings corrected for declination (6°W). All distances are to a nail and tag in the side of witness object unless otherwise noted.