

SURVEY & REMONUMENTATION

FEB 23 2001

LAND CORNER RECORDATION CERTIFICATE Filing Requirement of Act 74, Mich. P.A. 1970 Chippewa County Remonumentation Corner

SECTION

For corners in

Chippewa County	Located in:	Corner Code #
1. Public Land Survey	T47N R2E	C-10
	T R	
	T R	
	T R	
2. Property Controlling in Section	S T R	
3. Miscellaneous Property in Sec.	S T R	
	S T R	
4. Lot No. , Recorded Plat		
5. Private Claims		

\$7.00 LAND CORNER

\$2.00 MSSR

9 FEB 2001 10:31:12 AM Receipt #1201

RECEIVED FOR RECORD


CHIPPEWA COUNTY - STATE OF MICHIGAN
SHARON H. KENNEDY, REGISTER OF DEEDS

BOOK 11 PAGE 225

Register of Deeds Stamp & File Number

I, Larry R. Rogers, P.S., in a field survey on December 15, 2000, do hereby state that under requirements of P.A. 74, Michigan P.A. of 1970, the corner points mentioned in lines 1 and 2 above were in conformance with regulations and rules therefore as required in the current manual of survey instructions of the United States Department of the Interior, Bureau of Land Management or by a decree of a Court of Law and/or that the corner points mentioned in lines 3, 4 and 5 above were in conformance with the rules of the Michigan Board of Land Surveyors or by a Decree of a Court of Law; established, re-established, monumented, recovered, found as expressed below:

NOTE: Not more than 2 corners, all in the same town and range, may be recorded on this certificate.

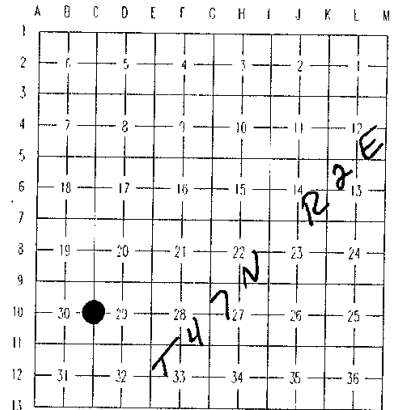

A. Description of original monument and accessories and/or subsequent restoration:

(C-10) 1/4 Corner common to Sections 29 and 30, Township 47 North, Range 2 East.

The original corner post was placed in 1845 by John Mullett. Early County Surveyor notes recite several conflicting distances for the line between Sections 29 and 30. An Alford Colwell survey in the 1930's gives distances of 2560 feet to the North and 2607 feet to the South of this corner.

B. Description of corner evidence found and/or method applied in restoring or reestablishing corner:

(C-10) 1/4 Corner common to Sections 29 and 30, Township 47 North, Range 2 East.

This corner is being perpetuated as part of the Chippewa County Remonumentation Program.

Found no evidence of original corner position. The measured distances between the Northwest and Southwest corners of Section 29 is 5167.04 feet (Colwell = 5167 feet). Re-established this corner position on line between the Northwest and Southwest corners of Section 29 at a prorated distance based upon Colwell survey.

C. Description of monument for corner and accessories established to perpetuate locating the position of the corner:

(C-10) 1/4 Corner common to Sections 29 and 30, Township 47 North, Range 2 East.

Corner is a 3/4" rebar with Chippewa County Remonumentation cap, 6" below grade and 3 feet West of centerline of Brasser Road (Chapman Road). Corner falls 15 feet South of the centerline of a two track trail to the West.

Witnesses:

9" Oak	N50°E	36.81 feet
7" Maple	S23°E	53.73 feet
7" Oak	S54°W	67.30 feet
18" Maple	N46°W	60.88 feet



Bearings are magnetic compass bearings. All distances are to a nail and tag in the side of the witness object unless otherwise noted.

Signed by 
Larry R. Rogers, P.S.
Surveyor's Michigan License No. 29251

Date 29 DEC 2000