

**SURVEY &
REMONUMENTATION**

FEB 23 2001

LAND CORNER RECORDATION CERTIFICATE
Filing Requirement of Act 74, Mich. P.A. 1970
Chippewa County Remonumentation Corner

SECTION

For corners in

Chippewa County

Located in:

Corner Code #

1. Public Land Survey

T47N R2E

E-5

2. Property Controlling
in Section

S

T

R

3. Miscellaneous
Property in Sec.

S


T

R

4. Lot No.

Recorded Plat

5. Private Claims

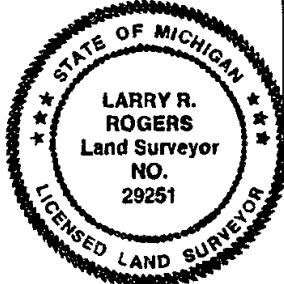

I, Larry R. Rogers, P.S., in a field survey on December 01, 2000, do hereby state that under requirements of P.A. 74, Michigan P.A. of 1970, the corner points mentioned in lines 1 and 2 above were in conformance with regulations and rules therefore as required in the current manual of survey instructions of the United States Department of the Interior, Bureau of Land Management or by a decree of a Court of Law and/or that the corner points mentioned in lines 3, 4 and 5 above were in conformance with the rules of the Michigan Board of Land Surveyors or by a Decree of a Court of Law; established, re-established, monumented, recovered, found as expressed below:

NOTE: Not more than 2 corners, all in the same town and range, may be recorded on this certificate.

\$7.00 LAND CORNER

\$2.00 MSSR

9 FEB 2001 10:33:23 AM Receipt #1201


RECEIVED FOR RECORD

CHIPPewa COUNTY - STATE OF MICHIGAN

SHARON H. KENNEDY, REGISTER OF DEEDS

BOOK 11 PAGE 233

Register of Deeds Stamp & File Number

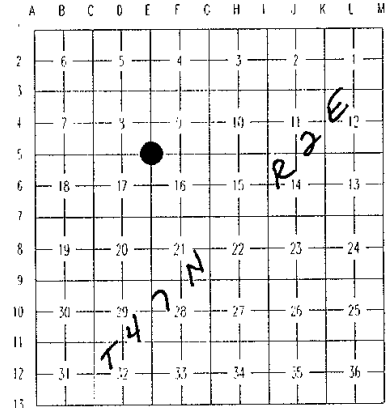

A. Description of original monument and accessories and/or subsequent restoration:

(E-5) Section corner common to Section 8, 9, 16 and 17, Township 47 North, Range 2 East.

The original corner post was placed in 1845 by John Mullett. Corner is referenced several times in County Surveyor notes as a bolt/iron pin. In 1981 W.L. Karr, P.S. 27450 found a 1" iron pin next to a wood post buried beneath the North - South county road (gravel). Karr accepted the corner position as found, established three new witnesses, and filed a L.C.R.C. in Liber 5 at Page 71 of the Chippewa County Corner Records.

B. Description of corner evidence found and/or method applied in restoring or reestablishing corner:

(E-5) Section corner common to Section 8, 9, 16 and 17, Township 47 North, Range 2 East

This corner is being perpetuated as part of the Chippewa County Remonumentation Program.

Found 1" iron pin next to remains of cut off wood post, 1.5 feet West of centerline of North - South gravel road and recovered three Karr witnesses intact. Distance North to 1/4 corner matches 1981 Karr survey. Distance South to 1/4 corner is 2606.7 feet (C.S. = 2605 feet) Distance West to 1/4 corner is 2604.7 feet (C.S. = 2609 feet) Accepted corner position as found and established one new witness.

C. Description of monument for corner and accessories established to perpetuate locating the position of the corner:

(E-5) Section corner common to Section 8, 9, 16 and 17, Township 47 North, Range 2 East.

Corner is a 1" iron pin next to the remains of a cut off wood post 1.5 feet West of the centerline of Townhall Road and on the extension of a fence to the West.

Witnesses:

End Fence Post	N78°W	37.55 feet	(Existing)
Utility Pole (SU1/27/50)	S30°W	108.16 feet	(Existing)
6" Spruce	S26°E	58.72 feet	(Existing)
5" Spruce	N29°E	93.16 feet	(New)

Bearings are magnetic compass bearings. All distances are to a nail and tag in the side of the witness object unless otherwise noted.

Signed by

Larry R. Rogers, P.S.

Surveyor's Michigan License No. 29251

Date

29 DEC 2000

FORM APPROVED BY MICHIGAN STATE BOARD OF PROFESSIONAL SURVEYORS, JAN. 28, 1971

BOOK 11 PAGE 233

REVISED MAY 14, 1975
REVISED JAN., 1983
REVISED OCT., 1995