

FEB 23 2001

SECTION

LAND CORNER RECORDATION CERTIFICATE

Filing Requirement of Act 74, Mich. P.A. 1970

Chippewa County Remonumentation Corner#7.00 LAND CORNER

For corners in

Chippewa County	Located in:	Corner Code #
1. Public Land Survey	T47N R2E	F-7
	T R	
	T R	
	T R	
2. Property Controlling	S T R	
in Section	S T R	
3. Miscellaneous	S T R	
Property in Sec.	S T R	
4. Lot No.	Recorded Plat	
5. Private Claims		

I, William L. Karr, P.S., in a field survey on June 6, 2000, do hereby state that under requirements of P.A. 74, Michigan P.A. of 1970, the corner points mentioned in lines 1 and 2 above were in conformance with regulations and rules therefore as required in the current manual of survey instructions of the United States Department of the Interior, Bureau of Land Management or by a decree of a Court of Law and/or that the corner points mentioned in lines 3, 4 and 5 above were in conformance with the rules of the Michigan Board of Land Surveyors or by a Decree of a Court of Law; established, re-established, monumented, recovered, found as expressed below:

NOTE: Not more than 2 corners, all in the same town and range, may be recorded on this certificate.

A. Description of original monument and accessories and/or subsequent restoration:

(F-7) 1/4 Corner Common to Sections 16 and 21, Township 47 North, Range 2 East.

1845 J. Mullett, D.S. set post.	Cedar 10	N19E	05
	Cedar 8	S66E	06

1915 and 1917 F.H. Brown County Surveyor notes corner as an original. Numerous surveys in Sections 16 and 21 used the corner. A deflection in the Section line at the 1/4 corner of 2°54' was noted.

B. Description of corner evidence found and/or method applied in restoring or reestablishing corner:

(F-7) 1/4 Corner Common to Sections 16 and 21, Township 47 North, Range 2 East.

This corner is being re-established as part of the Chippewa County Remonumentation Program.

Found no evidence of the original corner or subsequent restoration. Reset corner based on old fence lines to the East, West and South. Distance West to the Section corner is 2638.69 feet. Section corner to the East was lost and re-established from this corner position at record distance and at the record deflection angle. Section corner 16, 15, 22 and 21 fell 2637.46 feet South of 1/4 corner 16/15.

C. Description of monument for corner and accessories established to perpetuate locating the position of the corner:

(F-7) 1/4 Corner Common to Sections 16 and 21, Township 47 North, Range 2 East.

Corner is a 3/4" x 24" iron with stamped aluminum Chippewa County Remonumentation Corner cap and falls on East - West fence line (down) and fence line to South.

Witnesses:

Maple 12"	N37°E	38.24 feet
Maple 5"	N84°E	4.78 feet
Maple 12"	N67°W	28.40 feet
Balsam 5"	N09°W	45.18 feet

Bearings are magnetic compass bearings. All distances are to a nail and tag in the side of the witness object unless otherwise noted.

\$2.00 MSSR



9 FEB 2001 10:36:26 AM Receipt #1201

RECEIVED FOR RECORD

CHIPPEWA COUNTY - STATE OF MICHIGAN
SHARON H. KENNEDY, REGISTER OF DEEDS

BOOK 11 PAGE 239

Register of Deeds Stamp & File Number

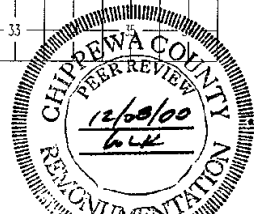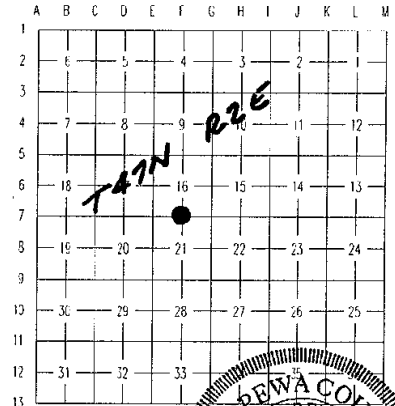

Signed by

William L. Karr, P.S.

Date 12/29/00

Surveyor's Michigan License No. 27450