


# LAKE SUPERIOR.

POSITION OF ORIGINAL  
MEANDER CORNER.

PRESENT WATERS' EDGE

WITNESS CORNER TO  
MEANDER CORNER  
BET. SECS' 6/5

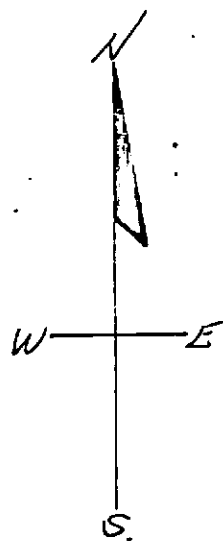

N. 0° 15' 53" E.  
1,320.0'

2,072.0'  
REC. = 2,395.8'  
SOUTH 1/16 CORNER

N. 89° 39' 51" E. 2,631.89' 6 5 N. 89° 01' 19" E. 2,550.88'  
SEC. COR. 7 8

T. 50 N. R. 6 W.  
CHIPPEWA CO.