

**JAN 23 2001**

**SECTION**

**LAND CORNER RECORDATION CERTIFICATE  
Filing Requirement of Act 74, Mich. P.A. 1970  
Clare County Remonumentation**

For Corners in  
Clare

(County)

Located In:

Corner Code#:

1. Public Land Survey T. 17N R. 3W C-3  
T. \_\_\_\_\_ R. \_\_\_\_\_  
T. \_\_\_\_\_ R. \_\_\_\_\_
2. Public Controlling S. \_\_\_\_\_ T. \_\_\_\_\_ R. \_\_\_\_\_  
in Section S. \_\_\_\_\_ T. \_\_\_\_\_ R. \_\_\_\_\_
3. Miscellaneous S. \_\_\_\_\_ T. \_\_\_\_\_ R. \_\_\_\_\_  
Property in Section S. \_\_\_\_\_ T. \_\_\_\_\_ R. \_\_\_\_\_
4. Lot No. \_\_\_\_\_, Recorded Plat \_\_\_\_\_
5. Private Claims \_\_\_\_\_

200000009707  
Filed for Record in  
CLARE COUNTY MICHIGAN  
CAROL MCAULAY  
On 11-29-2000 At 10:31 am.  
LAND CORNER 9.00  
OR Liber 2 Page 237 - 237

Instrument Liber Page  
200000009707 OR 2 237

# 442-00

Register of Deeds Stamp & File Number

I, Mark R. Robison, in a field survey on March 16, 2000, do hereby certify that under requirements of P.A. 74, Michigan P.A. of 1970, the corner points mentioned in lines 1 and 2 above were in conformance with regulations and rules therefore as required in the current manual of survey instructions of the United States Department of the Interior, Bureau of Land Management or by a decree of a Court of Law and/or that the corner points mentioned in lines 3, 4 and 5 above were in conformance with the rules of the Michigan Board of Land Surveyors or by a Decree of a Court of Law, established, re-established, monumented, re-monumented, recovered, found as expressed below.

**NOTE: Not more than 2 corners, all in the same town and range, may be recorded on this certificate.**

	A	B	C	D	E	F	G	H	I	J	K	L	M
1													
2	6	5	4	3	2	1							
3													
4	7	8	9	10	11	12							
5													
6	18	17	16	15	14	13							
7													
8	19	20	21	22	23	24							
9													
10	30	29	28	27	26	25							
11													
12	31	32	33	34	35	36							
13													

A. Description of original monument and accessories and/or subsequent restoration:

G.L.O.  
Nicholson, 1837

C.S.R.  
Harper, Bk. 1 Pg. 6  
Stake, Plow point & Crockery  
at intersection Hwy.  
C-3 to C-2 = 39.61 chains

G.L.O. Resurvey  
Burt, 1850

C.S.R.  
Bk. 5, Pg. 6 1872  
Bk. 5 Pg. 7 1886 & 1912  
Bk. 5 Pg. 8 1886 or 1889

Surveys  
None  
  
LCRC  
Lapham #381-80

**APPROVED LAND CORNER**  
P.A. 345 of 1990  
Clare County

Chairman Paul Skyles  
Date 5-10-00

B. Description of corner evidence found and/or method applied in restoring or re-establishing corner:


Found 5/8" S.R. in Monument Box. Found all witnesses from LCRC #381-80.  
Removed Mon. Box and excavated to depth of 4' found nothing further  
Measured from C-3 North to Fence West 2632 North to fence West 1312'; and North to fence East 1316' and South to fence West 1314'.  
Found iron is in centerline of intersection

C. Description of monument for corner and accessories established to perpetuate locating the position of the corner:  
Set 5/8" x 36" re-rod with Clare County Remon cap marked P.S. #27458 in Mon. Box. Accepted found iron as best available evidence of accepted position of the corner.

Witnesses:

N67°E, 66.70' - N & T in P.P. (OBT)  
N30°W, 64.80' - N & T in P.P. (OBT)  
N30°E, 101.0' - Southwest corner brick bldg. (OBT)  
N45°E, 64.70' - Northwest corner brick sign (OBT)

Signed by Mark R. Robison  
Surveyor's Michigan License No. 27458

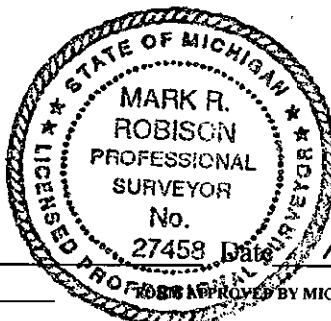

Date 11-28-2000