

SURVEY &  
REMONUMENTATION

JAN 23 2001

SECTION

LAND CORNER RECORDATION CERTIFICATE

Filing Requirement of Act 74, Mich. P.A. 1970

Clare County Remonumentation

For Corners in  
Clare  
(County)

*Indexed incorrectly - should be  
R4 W. See Liber 2, Page 305 #570*  
Located In: *Paul S. Lapham Co Rep.* Corner Code#:

200000010172  
Filed for Record in  
CLARE COUNTY MICHIGAN  
CAROL MCAULAY  
On 12-15-2000 At 07:44 am.  
LAND CORNER 9.00  
OR Liber 2 Page 295 - 295

1. Public Land Survey T. 17N R. 3W H-3  
T. \_\_\_\_\_ R. \_\_\_\_\_  
T. \_\_\_\_\_ R. \_\_\_\_\_ *Seg. 1*
2. Public Controlling S. \_\_\_\_\_ T. \_\_\_\_\_ R. \_\_\_\_\_  
in Section S. \_\_\_\_\_ T. \_\_\_\_\_ R. \_\_\_\_\_
3. Miscellaneous S. \_\_\_\_\_ T. \_\_\_\_\_ R. \_\_\_\_\_  
Property in Section S. \_\_\_\_\_ T. \_\_\_\_\_ R. \_\_\_\_\_
4. Lot No. \_\_\_\_\_, Recorded Plat \_\_\_\_\_
5. Private Claims \_\_\_\_\_

Instrument Liber Page  
200000010172 OR 2 295

#500-00

Register of Deeds Stamp & File Number

I, Mark R. Robison, in a field survey on November 28, 2000, do hereby certify that under requirements of P.A. 74, Michigan P.A. of 1970, the corner points mentioned in lines 1 and 2 above were in conformance with regulations and rules therefore as required in the current manual of survey instructions of the United States Department of the Interior, Bureau of Land Management or by a decree of a Court of Law and/or that the corner points mentioned in lines 3, 4 and 5 above were in conformance with the rules of the Michigan Board of Land Surveyors or by a Decree of a Court of Law, established, re-established, monumented, re-monumented, recovered, found as expressed below.

NOTE: Not more than 2 corners, all in the same town and range, may be recorded on this certificate.

	A	B	C	D	E	F	G	H	I	J	K	L	M
1													
2	6	5	4	3	2	1							
3													
4	7	8	9	10	11	12							
5													
6	18	17	16	15	14	13							
7													
8	19	20	21	22	23	24							
9													
10	30	29	28	27	26	25							
11													
12	31	32	33	34	35	36							
13													

A. Description of original monument and accessories and/or subsequent restoration:

GLO, Burt, 1850

Set Post

Hemlock 10" S29°E, 17 LINKS

Hemlock 6" N6°W, 15 LINKS

1989, Robison, (132), .3-138

Same witness as LCRC #538-86

1989, Lapham, (132) 3-140

Same witness as LCRC #538-86

Survey, MDOT, 1970, Unrecorded Survey

Set 3/4" x 12" lag screw in Mon. Box

Five witnesses

H-3 to I-3, 2646.16 feet

H-3 to G-3, 2660.33 feet

APPROVED LAND CORNER  
P.A. 345 of 1990

Clare County

Chairman *Paul S. Lapham*

Date 12-13-00

LCRC, Lapham, 1986, LCRC #538-86

Fd Mon. Box in C.L. Road

Three witnesses

B. Description of corner evidence found and/or method applied in restoring or re-establishing corner.

Fd 3/4" x 12" Lag screw in Mon. Box in C.L. E-W road & on line with East R/W fence of U.S. 27 x-way. Verified two 1970 witnesses and all 1986 witnesses. Accepted lag screw as best available evidence of the position of the corner.

C. Description of monument for corner and accessories established to perpetuate locating the position of the corner:

Set 5/8" x 36" rerod with Clare County Remon Cap marked P.S. #27458 in existing Mon. Box.

Witnesses:


S71°W, 44.23' - Chiseled x in S.E. Cor. Bridge wall (OBT)

N70°W, 44.23' - Chiseled x in N.E. Cor. Bridge wall (OBT)

N30°W, 21.32' - N & T in top of guard rail post (OBT)

S02°E, 15.15' - N & T in top of guard rail post (OBT)

Signed by *Mark R. Robison*  
Surveyor's Michigan License No. 27458

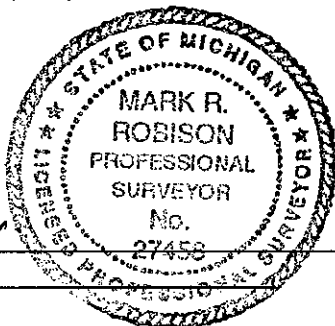

Date 12-14-2000