

LAND CORNER RECORDATION CERTIFICATE
Filing Requirement of Act 74, Mich. P.A. 1970

For corners in
CLARE

(County)

Located In:

Corner Code -##

1. Public Land Survey T 20N R 5W E-5, F-5,
T R B-5, B-6
T R
T R
T R
-2. Property Controlling S T R
in Section S T R
3. Miscellaneous S T R
Property in Sec. S T R

Register of Deeds Stamp & File Number

4. Lot No. , Recorded Plat
5. Private Claims

I, CARL F. ROSER, in a field survey on MAY 8, 19 89,
do hereby certify that under requirements of P.A. 74, Michigan P.A. of 1970, the corner points mentioned
in lines 1 and 2 above were in conformance with regulations and rules therefore as required in the
current manual of survey instructions of the United States Department of the Interior, Bureau of Land
Management or by a decree of a Court of Law and/or that the corner points mentioned in lines 3, 4 and 5
above were in conformance with the rules of the Michigan Board of Land Surveyors or by a Decree of a
Court of Law; established, re-established, monumented, re-monumented, recovered, found as
expressed below:

NOTE: Not more than 4 corners, all in the same town and range, may be recorded
on this certificate.

A. Description of original monument and accessories and/or subsequent restoration:


E-5

F-5

B-5

B-6

	A	B	C	D	E	F	G	H	I	J	K	L	M
2	6		5		4		3		2		1		
3													
4	7		8		9		10		11		12		
5													
6	18		17		16		15		14		13		
7													
8	19		20		21		22		23		24		
9													
10	30		29		28		27		26		25		
11													
12	31		32		33		34		35		36		
13													

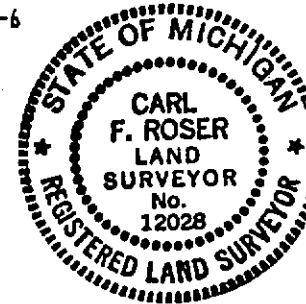

B. Description of corner evidence found and/or method applied in restoring or reestablishing corner:

E-5

F-5

B-5

B-6

FD CONSERVATION DEPT. MON FOR
NW COR SEC 16. IN 1962. RLS
KEN OSTLING FD GOOD STAKE
BOTTOM & REMAINS OF ARTHUR
JOHNSON. 1914± CO. SURVEYOR'S
WIT'S.

ACCEPTED FD 1" PIPE FOR 1/4
COR COMMON TO SEC'S 9 & 16.
COR PREVIOUSLY ESTABLISHED
MIDWAY & ON LINE BETWEEN FD
SEC CORNERS. 1/2 MILE E & W.
BY GOURDIE-FRASER & ASSOC. IN
1976 SURVEY, (CERT OF SURVEY
RECORDED IN LI 2, PG 238).

ACCEPTED FD 1 1/2" PIPE FOR NE
COR SEC 16. PROBABLY SET BY
MARCUS SCHAAF. SCHAAF'S 1942
RECORDS SAY HE FD THE SW STP
OF GLO BT IN PLACE. CTR TRAIL
RD N'LY & SW IS 60'± 3'W.
FD 1 1/2" PIPE WAS WIT & USED
BY G.F. & ASSOC.

ACCEPTED FD 4" ROUND CONC MON
FOR E 1/4 SEC 16. GOURDIE
FRASER & ASSOCIATES SET THIS
MIDWAY & ON LINE BETWEEN NE &
SE SEC 16 IN 1976.

C. Description of monument for corner and accessories established to perpetuate locating the position of the corner:

E-5

F-5

B-5

B-6

FD DEPT MON & ADDED CED POST.
#10" R PINE N76°E 28.22'
#10" R PINE S42°W 41.27'
9" OAK N40°W 58.05'
#14" R PINE S68°W 56.1'

FD 1" PIPE; ADDED CED POST
W/LOC TAG.
#10" R PINE N15°E 16.98'
#12" B OAK S45°E 22.15'
#12" R PINE S20°W 17.40'
4" R PINE N80°W 3.22'

FD OLD 1 1/2" PIPE; ADDED CED
POST W/LOC TAG.
#12" R PINE N05°W 11.50'
8" R PINE S70°E 15.52'
#11" R PINE S15°E 21.00'
#POWER POLE S87°W 47.04'

FD 4" ROUND CONC MON; ADDED
CED POST W/LOC TAG.
4" W PINE N30°W 49.53'
5" W PINE N12°E 36.00'
#27" W PINE N45°E 117.60'
6" B OAK S25°E 20.42'
TOP BANK S OF
MUSKEGON RVR DUE N 60'± 2'
#GOURDIE FRASER & ASSOC WITS.

*WIT USED BY J. MILCOX & G.
DELAMATER.
*WIT USED BY K. OSTLING.

*GOURDIE FRASER & ASSOC. & RLS
M. MCCLUNG WITS.

*GOURDIE FRASER & ASSOC WIT.

Signed by Carl F. Roser Date 8-10-92

Surveyor's Michigan License No. 12028