

SURVEY &  
REMONUMENTATION

FEB 02 1998

SECTION

REMONUMENTATION  
SECTION 3, DEWITT TOWNSHIP  
LAND CORNER RECORDATION CERTIFICATE  
Filing Requirement of Act 74, Mich. P.A. 1970

LIBER 004 PAGE 196

RECORDED

For corners in

Clinton  
(County)

Located in:

Corner Code #

1. Public Land Survey

T\_5N\_ R\_2W\_

\_H-1\_

T\_ R\_

T\_ R\_

T\_ R\_

2. Property Controlling  
In Section

S\_ T\_ R\_

S\_ T\_ R\_

3. Miscellaneous  
Property in Sec.

S\_ T\_ R\_

S\_ T\_ R\_

4. Lot No. \_\_\_\_\_ Recorded Plat \_\_\_\_\_

5. Private Claims \_\_\_\_\_

OCT 17 9 17 AM '97

REGISTER OF DEEDS  
CLINTON COUNTY, MICH.

*Carol Worley*

I, Mark L. VanRaemdonck, in a filed survey on August 21, 1997, do hereby certify that under requirements of P.A. 74, Michigan P.A. of 1970, the corner points mentioned in lines 1 and 2 above were in conformance with regulations and rules therefore as required in the current manual of survey instructions of the United States Department of the Interior, Bureau of Land Management or by a decree of a Court of Law and/or that the corner points mentioned in lines 3, 4 and 5 above were in conformance with the rules of the Michigan Board of Land Surveyors or by a Decree of a Court of Law; established, re-established, monumented, re-monumented, recovered, found as expressed below:

NOTE: Not more than 2 corners, all in the same town and range, may be recorded on this certificate.

A. Description of original monument and accessories and/or subsequent restoration:

1. Ron Helsel, L.C.R.C. L. 1, P. 633 5/1/73

Monument set 1/2" iron in centerline of Round Lake Road. Set 9.78 West of South 1/4 corner of Section 34, T6N-R2W, Olive Township, from Government notes.

Accessories:

A. 4" Ash N15°E 31.37'

B. Pine Fence Post S25°E 31.83'

C. 4" Ash N45°W 27.87'

2. Ron Helsel, Cert. Survey L. 1, P. 432, 11/20/73

Refers to No. 1 Above

3. Ron Helsel, Cert. Survey L. 1, P. 520 5/15/74

Refers to No. 1 Above

4. Ron Helsel, Cert. Survey L. 1, P. 738, 1/13/76

Refers to No. 1 Above

(continued on reversed side of this sheet)

B. Description of corner evidence found and/or method applied in restoring or re-establishing corner:

This position was not established by the original Government Surveyors. Found rerod in Mon box as referenced in No. 1 above. This monument is accepted as the best available evidence of the position of the corner.

C. Description of monument for corner and accessories to perpetuate locating the position of the corner

Removed rerod and replaced it with a standard Clinton County Remonumentation Monument. The Monument is witnessed by the following accessories:

N20W 41.06' Nail & Tag #25832 in E. face 18" Poplar

S20E 28.21' Nail & Tag #15039 in W. face 12" Poplar

S05W 32.03' Nail & Tag #24622 in E. face 10" Poplar

S89°41'13E 9.84' STD Clinton County Mon at H-13, T6N-R2W

N89°47'46"W 2642.04' 1/2" Rerod in Mon Box at G-1, T5N-R2W


Register of Deeds Stamp & File Number

	A	B	C	D	E	F	G	H	I	J	K	L	M
2	6		5		4		3		2		1		
3													
4	7		8		9		10		11		12		
5													
6	13		17		18		15		14		13		
7													
8	19		20		21		22		23		24		
9													
10	25		29		28		27		26		25		
11													
12	31		32		33		34		35		36		
13													

Signed by

*Mark L. VanRaemdonck*

Surveyor's Michigan License No. 24622

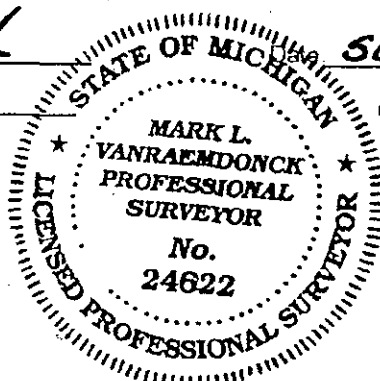

SEPT 8, 1997

FORM APPROVED BY MICHIGAN STATE BOARD OF LAND SURVEYORS JAN 18, 1971  
REVISED MAY 14, 1975  
REVISED JAN. 1983

APPROVED BY  
CLINTON COUNTY PEER GROUP  
DATED 8/19/97

*J. 78*

A. Description of original monument and accessories and/or subsequent restoration:

(continued from front)

5. Ronnie Lester, Cert. Survey L. 2, P. 33 11/4/81  
Refers to No. 1 Above
6. Fred N. White, Cert. Survey L. 2, P. 451 4/12/78  
Refers to No. 1 Above
7. Fred N. White, Cert. Survey L.2, P. 629 5/9/83  
No mon. or access. given
8. Douglas K. Richardson, Cert. Survey L.3, PP. 197, 2/26/87  
Refers to No. 1 Above
9. Douglas K. Richardson, Cert. Survey L.3, P. 436, 12/2/88  
Refers to No. 1 Above
10. Douglas K. Richardson, Cert. Survey L.3, P. 435 12/2/88  
Refers to No. 1 Above
11. Douglas K. Richardson, Cert. Survey L.3, P. 283, 4/20/88  
Refers to No. 1 Above

LIBER 004 PAGE 197