

# SURVEY & REMONUMENTATION

FEB 02 1998

## REMONUMENTATION

### SECTION 33, OLIVE TOWNSHIP

### SECTION

### LAND CORNER RECORDATION CERTIFICATE

Filing Requirement of Act 74, Mich. P.A. 1970

RECORDED

For corners in

Clinton  
(County)

Located In:

Corner Code #

1. Public Land Survey

T 6N R 2W

G-13

2. Property Controlling  
in Section

S T R

3. Miscellaneous

S T R

Property in Sec.

S T R

4. Lot No. \_\_\_\_\_, Recorded Plat \_\_\_\_\_

5. Private Claims \_\_\_\_\_

Nov 4 1 26 PM '97

REGISTER OF DEEDS  
CLINTON COUNTY, MICH.

4 PAGE 250

LIBER

Register of Deeds Stamp & File Number

I, Arden S. Pierson, PS, in a field survey on July 23 19 97, do hereby certify that under requirements of P.A. 74, Michigan P.A. of 1970, the corner points mentioned in lines 1 and 2 above were in conformance with regulations and rules therefore as required in the current manual of survey instructions of the United States Department of the Interior, Bureau of Land Management or by a decree of a Court of Law and/or that the corner points mentioned in lines 3, 4 and 5 above were in conformance with the rules of the Michigan Board of Land Surveyors or by a Decree of a Court of Law; established, re-established, monumented, re-monumented, recovered, found as expressed below:

NOTE: Not more than 2 corners, all in the same town and range, may be recorded on this certificate.

A. Description of original monument and accessories and/or subsequent restoration:

◆Original survey by Hervey Parke, DS, 1826. Witnesses: W. Oak 18" - N73°E - 22 links; W. Oak 7" - N88°W - 16 links.

◆Survey by Chas. E. Hollister, County Surveyor, 1890. Found the old stake set for corner sections 33 and 34, and found the remains of stump at point N73°E - 21 links given in field notes.

(OVER)

APPROVED BY  
CLINTON COUNTY PEER GROUP  
DATED 8/20/97

B. Description of corner evidence found and/or method applied in restoring or reestablishing corner:

Set P.K. Nail in Westerly side North Bound Lane Highway U.S.-27 on Township Line and is accepted as a careful and faithful re-establishment of the position of the original corner.

(Closing Corner for T5N, R2W, is 19.14' West)

C. Description of monument for corner and accessories established to perpetuate locating the position of the corner:

Southeast Corner, Section 33

\*P.K. Nail

Nail & tag #13039 in NE side power pole - N19°E - 76.47'

Nail & tag #13039 in SW side power pole - N54°E - 114.09'


SE corner of concrete R/W Marker - S8°E - 83.36'

Nail & tag #13039 in North side power pole - S27°W - 135.49'

Closing corner G-1, T5N, R2W is used as a reference monument

N89°35'35"W 19.14'. To F-13, T6N, R2W - N89°35'35"W. 2637.78'

From solar observations.

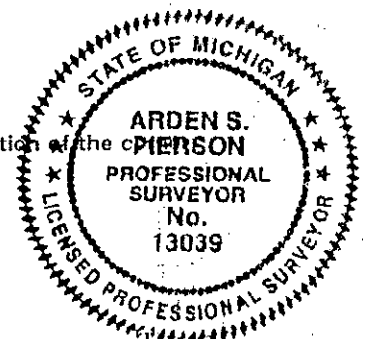

Signed by

*Arden S. Pierson*

Date

July 30, 1997

Surveyor's Michigan License No.

13039

FORM APPROVED BY MICHIGAN STATE BOARD OF LAND SURVEYORS, JAN. 28, 1971

REVISED MAY 14, 1975

REVISED JAN., 1983

ADAPTED FOR WORD PROCESSING MARCH, 1993

◆LCRC by Ron Helsel, PS, #18994, dated November 7, 1972, Liber 1, Page 605. Set Corner 19.10 east of the NE Corner Section 4, T5N, R2W, DeWitt Township (GLO notes 19.14') by single proportionate measurement along township line. Witnessed by:

N50°E - 74.25' - NW Corner of concrete R.O.W. marker North side of Cutler Road  
S30°W - 38.91' - NE Corner of Catch Basin in Median of U.S. 27  
N38°E - 74.48' - Centerline of 12" steel sign post

◆Certificate of Survey by Ron Helsel, PS, #18994, dated November 22, 1972, Liber 1, Page 246.

◆Certificate of Survey by Arden S. Pierson, PS, #13039, dated November 24, 1993, Liber 1, Page 962.

◆Certificate of Survey by Douglas K. Richardson, PS, #31603, dated February 18, 1993, Liber 4, Page 693.

◆Certified Survey Map by Arden S. Pierson, PS, #13039, dated July 23, 1994. Liber 4, Pages 980-981.