

APR 27 1995

CRAWFORD COUNTY
PEER GROUP APPROVAL
DATE DEC 27, 1994
M/881

LIBER 3 PAGE 174

COMMISSION

LAND CORNER RECORDATION CERTIFICATE
Filing Requirement of Act 74, Mich. P.A. 1970

For corners in

Crawford Located In: Corner Code ##
(County)

1. Public Land Survey T 25N R 2W E-10
T R
T R
T R

2. Property Controlling S T R
in Section S T R

3. Miscellaneous S T R
Property in Sec. S T R

4. Lot No. , Recorded Plat
5. Private Claims

STATE OF MICHIGAN

COUNTY OF CRAWFORD

FILED FOR RECORD THIS
30th DAY OF Dec, 1994 AT
4:20 am (pm) IN LIBER 3
PAGE 174.

Edith A. L. Leland
Register of Deeds Stamp & File Number

| | A | B | C | D | E | F | G | H | I | J | K | L | M |
|----|----|----|----|----|----|----|---|---|---|---|---|---|---|
| 2 | 6 | 5 | 4 | 3 | 2 | 1 | | | | | | | |
| 3 | | | | | | | | | | | | | |
| 4 | 7 | 8 | 9 | 10 | 11 | 12 | | | | | | | |
| 5 | | | | | | | | | | | | | |
| 6 | 18 | 17 | 16 | 15 | 14 | 13 | | | | | | | |
| 7 | | | | | | | | | | | | | |
| 8 | 19 | 20 | 21 | 22 | 23 | 24 | | | | | | | |
| 9 | | | | | | | | | | | | | |
| 10 | 30 | 29 | 28 | 27 | 26 | 25 | | | | | | | |
| 11 | | | | | | | | | | | | | |
| 12 | 31 | 32 | 33 | 34 | 35 | 36 | | | | | | | |
| 13 | | | | | | | | | | | | | |

I, Marvin E. Myers, in a field survey on Dec 27, 1994,
do hereby certify that under requirements of P.A. 74, Michigan P.A. of 1970, the corner points mentioned
in lines 1 and 2 above were in conformance with regulations and rules therefore as required in the
current manual of survey instructions of the United States Department of the Interior, Bureau of Land
Management or by a decree of a Court of Law and/or that the corner points mentioned in lines 3, 4 and 5
above were in conformance with the rules of the Michigan Board of Land Surveyors or by a Decree of a
Court of Law; established, re-established, monumented, re-monumented, recovered, found as
expressed below:


NOTE: Not more than 4 corners, all in the same town and range, may be recorded
on this certificate.

A. Description of original monument and accessories and/or subsequent restoration:
GLO-Pettibone 1852 F. Arleth 7-31-1986 L.247, P.555
Mon-Set Post Mon- 1½" Pipe (1949)
Wit- 8" Sp. Pine S23°W 1.80 chs.
8" Y. Pine S50°E 1.50 chs.

R. Ostling 9-1956
Mon- Iron
Wit- None given

B. Description of corner evidence found and/or method applied in restoring or reestablishing corner:
Found PK nail 0.8 West of Centerline of DeerHeart Valley Road. 0.2 East of ½"x18" iron bar
and Cap #2240 0.8 below asphalt road surface.
Accepted as the best available evidence of the position of the Original Corner.

C. Description of monument for corner and accessories established to perpetuate locating the position of the corner:
Mon-Set standard Crawford County Monument marked cap "31600 MEM E-10" in exact location of
found ½" bar and cap.
Wit-Set nail & tag S. side Utility Pole S85°E 28.96
Set nail & tag SW side 11" J. Pine with old blaze on face S35°E 71.88
Set nail & tag SE side 7" J. Pine with blaze on face S60°W 47.00
Set nail & tag NE side 10" J. Pine with found blaze on face N38°W 60.03
Set Carsonite Post N84°W 36.06
Found blaze West face 13" J. Pine S70°E 48.30
Found Concrete Mon S85°E 33.19

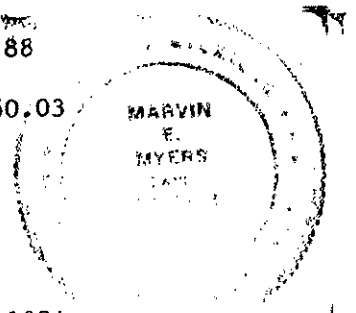

Signed by Marvin E. Myers
Surveyor's Michigan License No. 31600

Date Dec 27, 1994